

SURVEY & REMONUMENTATION

FEB 25 1999

FILED

SECTION

LAND CORNER RECORDATION CERTIFICATE Filing Requirement of Act 74, Mich. P.A. 1970

For corners in

Livingston
(County)

Located In:

Corner Code //

1. Public Land Survey

T 2N R 6E

H-3

2. Property Controlling
in Section

S T R
S T R

3. Miscellaneous
Property in Sec.

S T R
S T R

4. Lot No. , Recorded Plat

5. Private Claims

1998 OCT 27 P 2:23

NANCY HAVILAND
REGISTER OF DEEDS
LIVINGSTON COUNTY, MI.
48843

LSC980M

Register of Deeds Stamp & File Number

I, Bryan L. BOSS, in a field survey on Oct. 7, 1998,
do hereby certify that under requirements of P.A. 74, Michigan P.A. of 1970, the corner points mentioned
in lines 1 and 2 above were in conformance with regulations and rules therefore as required in the
current manual of survey instructions of the United States Department of the Interior, Bureau of Land
Management or by a decree of a Court of Law and/or that the corner points mentioned in lines 3, 4 and 5
above were in conformance with the rules of the Michigan Board of Land Surveyors or by a Decree of a
Court of Law; established, re-established, monumented, re-monumented, recovered, found as
expressed below:

NOTE: Not more than 4 corners, all in the same town and range, may be recorded
on this certificate.

A. Description of original monument and accessories and/or subsequent restoration:

Set $\frac{1}{4}$ section post at average distance on true line
Poplar 6" S 81 E 20 links
Poplar 6" N 54 W 40 links

B. Description of corner evidence found and/or method applied in restoring or reestablishing corner:


Found capped iron #24607/10057

P.A. 345 1990, APPROVED BY LIVINGSTON COUNTY
PEER GROUP ON 9-2-98 CO. REP LED

C. Description of monument for corner and accessories established to perpetuate locating the position of the corner:

Set $1\frac{1}{4}$ " by 36" pipe with Brass cap stamped "Livingston County
Remonumentation"

North 16.49 set Remon N/T Eastside 10" Poplar
East 17.03 set Remon N/T Norhtside 24" twin Ash
West 18.42 set Remon N/N Northeast side 10" Poplar
S 35 E 20.08 set Remon N/T Northeast side 10" Ash

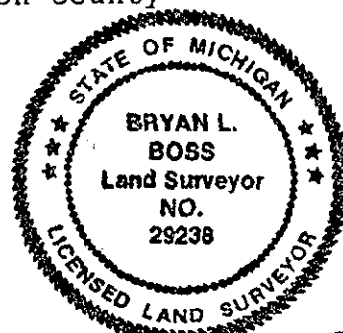

Signed by

Bryan L. Boss

Date

10-16-1998

Surveyor's Michigan License No.

29238