

SURVEY & REMONUMENTATION

APR 28 1995

COMMISSION AND CORNER RECORDATION CERTIFICATE

Filing Requirement of Act 74, Mich. P.A. 1970

FILED

NOV 16 11 04 AM '94

NANCY HAVILAND
REGISTER OF DEEDS
LIVINGSTON COUNTY, MI
48843

For corners in
Livingston

(County)

Located In:

Corner Code ##

1. Public Land Survey T 2N R 6E K-7
T R
T R
T R
2. Property Controlling S T R
In Section S T R
3. Miscellaneous S T R
Property in Sec. S T R

L.S.C. #320m

Register of Deeds Stamp & File Number

4. Lot No. , Recorded Plat
5. Private Claims

	A	B	C	D	E	F	G	H	I	J	K	L	M
2	6	5	4	3	2	1							
3													
4	7	8	9	10	11	12							
5													
6	18	17	16	15	14	13							
7													
8	19	20	21	22	23	24							
9													
10	30	29	28	27	26	25							
11													
12	31	32	33	34	35	36							
13													

I, Bryan Boss, in a field survey on 9-15, 19 94, do hereby certify that under requirements of P.A. 74, Michigan P.A. of 1970, the corner points mentioned in lines 1 and 2 above were in conformance with regulations and rules therefore as required in the current manual of survey instructions of the United States Department of the Interior, Bureau of Land Management or by a decree of a Court of Law and/or that the corner points mentioned in lines 3, 4 and 5 above were in conformance with the rules of the Michigan Board of Land Surveyors or by a Decree of a Court of Law; established, re-established, monumented, re-monumented, recovered, found as expressed below:

NOTE: Not more than 4 corners, all in the same town and range, may be recorded on this certificate.

A. Description of original monument and accessories and/or subsequent restoration:

White Oak 6" N 75 W 4 Links
White Oak 8" S 80 E 3 Links
White Oak 20" N 80 E 2 ft.


ADDITIONAL HISTORICAL DATA ON BACK OF SHEET

B. Description of corner evidence found and/or method applied in restoring or reestablishing corner:

Found 1 1/2" inch well point at downed North, South, East and West fence. Checked to 1955 witnesses. K-7 is located in the General Motors Proving Grounds.

C. Description of monument for corner and accessories established to perpetuate locating the position of the corner:

Set 1 1/4" x 36" Iron Pipe with brass cap marked Livingston County Monument Corner.
Southwest 10.26' N/T 10" Ash
Southeast 27.96' N/T 10" Maple
North 18.35' N/T E/S tree
Northeast 23.75' N/T W/S tree

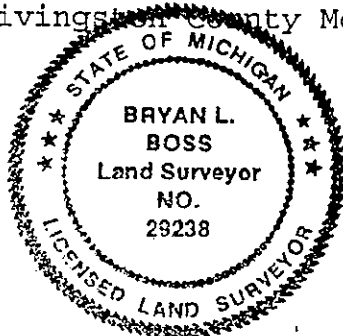

Signed by Bryan L. Boss Date 11-10-1994

Surveyor's Michigan License No. 29238

FORM APPROVED BY MICHIGAN STATE BOARD OF LAND SURVEYORS, JAN. 28, 1971
REVISED MAY 14, 1975
REVISED JAN., 1983

P.A. 345 1980, APPROVED BY LIVINGSTON COUNTY

PEER GROUP ON 2-1 Sep 94 CO. REP

T2N-R6E K-7 Pg. 1

BOSS ENGINEERING

ENGINEERS & SURVEYORS

SUMMARY K-7

NORTHWEST CORNER, SECTION 24, T2N-R6E BRIGHTON TOWNSHIP, LIVINGSTON COUNTY, MICHIGAN.


Found 1 1/2" inch well point at downed fence North, South, East and West. Found 2 of 3 Warner & Warner 1955 Witnesses imbedded in trees and they checked. Utilized sounder to located Witnesses pages 13, 14 this Dossier.

Distance from the Northwest Corner of Section 24 to the North Right-of-Way monument of Stobart Road is 395.90' feet. See page 6 of this Dossier.

Distance Northerly from the Northwest Corner of Section 24 to the South Edge of the General Motors Proving Grounds Service Road is 122.0 feet (new Witness).

Distance from the Northwest Corner of Section 24 to the North 1/4 Corner of Section 23 is 2587.91' feet, 2587.65' feet and 2586.37' feet on 3 Surveys by Boss Engineering.

Conclusion: We find the 1955 Witnesses (in conjunction with the consistent measurements of 395.90' feet Southerly to Stobart Road Right-of-Way) merit justification in accepting this location as the Northwest Corner of Section 24.

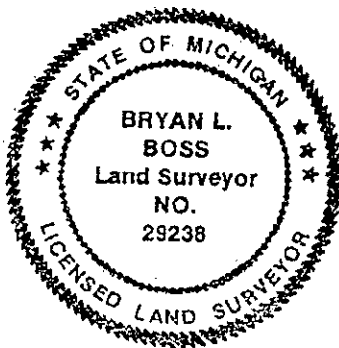

A handwritten signature in cursive script, appearing to read "Bryan L. Boss", written over the right side of the professional seal.

file: summk7