

JUN 01 1998

LAND CORNER RECORDATION CERTIFICATE
Filing Requirement of Act 74, Mich. P.A. 1970

FILED

For corners in

LIVINGSTON
(County)

Located In:
BRIGHTON TWP.

Corner Code -//

1998 MAY 29 P 1:44

NANCY HAVILAND
REGISTER OF DEEDS
LIVINGSTON COUNTY, MI.
48843

L.S.C. #844m

(See L.S.C.#83 Im)

Register of Deeds Stamp & File Number

- ### 1. Public Land Survey

T...R

T R

T and R **R** and R

[illegible]

T R

$$\frac{1}{2M} \frac{R}{\epsilon F}$$

THE ROYAL CANADIAN MOUNTED POLICE

001

- 2. Property Controlling in Section**

S T P

S 01 T 2N R 6E

S I B

- ### 3. Miscellaneous Property in Se

S I B

1998, 1999, 2000, 2679, 26

4. Lot No. _____, Recorded Plat _____

- ## 5. Private Claims

I, **BRYAN L. BOSS**, in a field survey on **SEPTEMBER 22,** 19**97**, do hereby certify that under requirements of P.A. 74, Michigan P.A. of 1970, the corner points mentioned in lines 1 and 2 above were in conformance with regulations and rules therefore as required in the current manual of survey instructions of the United States Department of the Interior, Bureau of Land Management or by a decree of a Court of Law and/or that the corner points mentioned in lines 3, 4 and 5 above were in conformance with the rules of the Michigan Board of Land Surveyors or by a Decree of a Court of Law, established, re established, monumented, re monumented, recovered, found as expressed below

NOTE: Not more than 4 corners, all in the same town and range, may be recorded on this certificate.

- A Description of original monument and accessories and/or subsequent restoration


CLOSED ON THE EAST SIDE OF THE SWAMP. COULD NEITHER SET THE 1/2 MILE NOR THE MILE POST. CONTINUED SOUTH 15 CHAINS ON THE SECOND MILE, THEN TURNED WEST 14 CHAINS TO THE LINE.

- B. Description of corner evidence found and/or method applied in restoring or reestablishing corner:

FOUND 1" INCH X 24" POINTED SHAFT AT BASE OF WOOD POST.
FENCE REMNANTS FOUND NORTH-SOUTH AND WEST.

- C. Description of monument for corner and accessories established to perpetuate locating the position of the corner:

-001 OF 1
SET 1 1/4" X 36" PIPE WITH BRASS CAP STAMPED
"LIVINGSTON COUNTY MONUMENTATION WITNESS CORNER".
NORTH 34.58' NAIL & TAG WEST SIDE 8" TWIN CHERRY
S 70 E 22.60' NAIL & TAG SOUTH SIDE 6" CHERRY
S 02 W 12.00' NAIL & TAG WEST SIDE 10" TWIN CHERRY
S 85 W 22.83' NAIL & TAG SOUTH SIDE 6" BOX ELDER

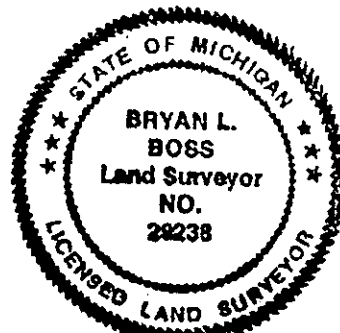

Signed by *A. Eugene H. Barr*
Surveyor's Michigan License No. 29238

Date MAY 20 1998

FORM APPROVED BY MICHIGAN STATE BOARD OF LAND SURVEYORS, JAN. 28, 1971
REVISED MAY 16, 1975
REVISED JAN. 1983

RA. 245 1000, APPROVED BY LINCOLN COUNTY
FEAR GROUP ON 9-17-97 CO. REP. JED

**SUMMARY
M-2**

East 1/4 Corner, Section 1, Brighton Township.

G.L.O. Notes record neither the East 1/4 Corner nor the Southeast Corner of Section 1 were ever set. The notes also record measurements logged North to South. (see page 5 of dossier for sketch of GLO measurements)

Found 1 inch x 2 ft. pointed shaft at base of wood post. Reset disturbed shaft on East side of post. Fence remnants found North-South and West. Boss Engineering ran G.P.S. through this point.


The Warner and Warner survey in 1954 refers to this corner and many accessory corners. This map shows all Corners from M-1 through M-7 and is the only survey of substance in this area. Boss ran the entire "M" line thru the GM Proving Grounds and found that the measurement from M-1 to M-7 is within 0.60 feet from the distance computed on the Warner survey.

The Midwestern Consulting survey of 1988 appears to be a control survey within the limits of the GM proving Grounds. This survey appears to use the Warner Survey of 1954 as its basis but does not retrace any of the Warner survey along the "M" line of Brighton Township (Note that all of the computed measurements of this survey match the Warner Survey).

We find that the distances to M-1 and to the iron in the Mon Box in Commerce Road match the Warner survey.

We recommend using the existing point, as found, for M-2.

SUMBM-2

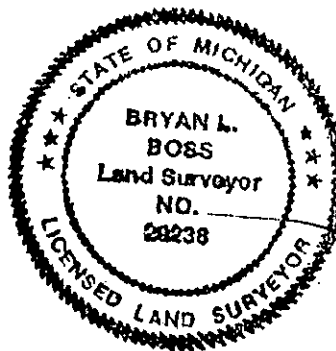

Bryan L. Boss