

MAR 17 2000

FILED

SECTION

LAND CORNER RECORDATION CERTIFICATE  
Filing Requirement of Act 74, Mich. P.A. 1970

For corners in

LIVINGSTON

(County)

Located In:

Corner Code #

1. Public Land Survey

T3N R3E I 4

T R

T R

T R

2. Property Controlling  
in Section

S T R

S T R

3. Miscellaneous  
Property in Sec.

S T R

S T R

4. Lot No. , Recorded Plat

5. Private Claims

1999 MAY 21 A 9:21

NANCY HAVILAND  
REGISTER OF DEEDS  
LIVINGSTON COUNTY, MI.  
48843

L.S.C.#1000

Register of Deeds Stamp & File Number

I, CHARLES E GARLOCK, in a field survey on APRIL 28, 1999 do hereby state that under requirements of P.A. 74, Michigan P.A. of 1970, the corner points mentioned in lines 1 and 2 above were in conformance with regulations and rules therefore as required in the current manual of survey instructions of the United States Department of the Interior, Bureau of Land Management or by a decree of a Court of Law and /or that the corner points mentioned in lines 3, 4 and 5 above were in conformance with the rules of the Michigan Board of Land Surveyors or by a Decree of a Court of Law; established, re-established, monumented, recovered, found as expressed below:

NOTE: Not more than 2 corners, all in the same town and range, may be recorded on this certificate.

A. Description of original monument and accessories and/or subsequent restoration:

GLO SURVEY DATED APRIL 15, 1825 BY S SIBLEY AND NONE OF THE GLO WITNESSES REMAIN.  
GLO WITNESSES: W011-S10E-29.04'  
B07-N35½E-46.2'

B. Description of corner evidence found and/or method applied in restoring or reestablishing corner:

FOUND 1/2" I. ROD IN C/L ASPHALT ROAD, IN LINE WITH FENCES EAST AND WEST AND MATCHES 1903 WITNESSES REMAINING BY MC CREARY.

C. Description of monument for corner and accessories established to perpetuate locating the position of the corner:


I 4: E 1/4 COR. SEC. 10, T3N-R3E, HANDY TWP. LIV. CO. MI. RESET FOUND IRON WITH MON BOX AND 1 1/4" X 36" BREAKAWAY I. PIPE WITH LIV. CO. REMON CAP ON TOP #14762  
WEST-58.23'-SP & TAG S/S 36" MAPLE  
N65W-62.92'-SE COR. HSE FDN. #415  
S60W-65.53'-NE COR. HSE. FDN. #409  
S85E-24.54'-SP & TAG S/S U POLE  
N40W-43.76'-SP & TAG E/S 18" MAPLE

Signed by

*Charles E. Garlock*

Date MAY 1, 1999

Surveyor's Michigan License No. 14762

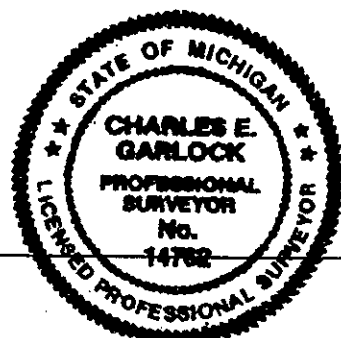

P.A. 345 1990, APPROVED BY LIVINGSTON COUNTY

PEER GROUP ON 3-17-99, CO. REP JED