

SURVEY &  
REMONUMENTATION

FEB 26 2001

SECTION

LAND CORNER RECORDATION CERTIFICATE  
Filing Requirement of Act 74, Mich. P.A. 1970

FILED

For corners in

LIVINGSTON  
(County)  
1. Public Land Survey  
2. Property Controlling  
in Section  
3. Miscellaneous  
Property in Sec.  
4. Lot No. \_\_\_\_\_, Recorded Plat \_\_\_\_\_  
5. Private Claims \_\_\_\_\_

Located In: T 3 N R 3 E  
Corner Code # F-05

S T R  
S T R  
S T R  
S T R

2000 OCT 30 A 9:23

NANCY HAVILAND  
REGISTER OF DEEDS  
LIVINGSTON COUNTY, MI.  
48843

LSC #1344m

Register of Deeds Stamp & File Number

	A	B	C	D	E	F	G	H	I	J	K	L
1												
2		6		5		4		3		2		1
3												
4		7		8		9		10		11		12
5												
6		18		17		16		15		14		13
7												
8		19		20		21		22		23		24
9												
10		30		29		28		27		26		25
11												
12		31		32		33		34		35		36
13												

I, JACK K. SMITH, in a field survey on OCTOBER 11, 2000, do hereby state that under requirements of P.A. 74, Michigan P.A. of 1970, the corner points mentioned in lines 1 and 2 above were in conformance with regulations and rules therefore as required in the current manual of survey instructions of the United States Department of the Interior, Bureau of Land Management or by a decree of a Court of Law and /or that the corner points mentioned in lines 3, 4 and 5 above were in conformance with the rules of the Michigan Board of Land Surveyors or by a Decree of a Court of Law; established, re-established, monumented, recovered, found as expressed below:

NOTE: Not more than 2 corners, all in the same town and range, may be recorded on this certificate.

A. Description of original monument and accessories and/or subsequent restoration:

GLO 1825 SYLVESTER SIBLEY SET POST  
SYCAMORE 10" N43 1/2°E 25.08'  
BEECH 8" S80°W 15.18'

B. Description of corner evidence found and/or method applied in restoring or reestablishing corner:

THE EXISTING CORNER IS A "MAG NAIL" SET IN 2000 BY JACK SMITH NEAR THE INTERSECTION OF THE CENTERLINES OF THE RAIL ROAD TRACKS (E-W) AND POTTS ROAD (N-S). THIS APPEARS TO BE THE ONLY POSITION USED SINCE 1968 AND POSSIBLY SINCE 1875.

C. Description of monument for corner and accessories established to perpetuate locating the position of the corner:


F-05 SOUTH 1/4 CORNER SECTION 9, T3N, R3E, HANDY TOWNSHIP, LIVINGSTON COUNTY, MICHIGAN:  
SET MAG NAIL IN CENTERLINE OF THE RAILROAD AND POTTS ROAD AND SET TWO 1" PIPES WITH WITNESS BRASS CAPS STAMPED SURVEYOR #35999 AS DESCRIBED BELOW.

N40°15'13"W 1" PIPE WITH LIVINGSTON COUNTY REMON BRASS WITNESS CAP (CARSONITE POST 0.5' S) 52.76'  
S40°15'13"E 1" PIPE WITH LIVINGSTON COUNTY REMON BRASS WITNESS CAP (CARSONITE POST 0.5' N) 47.60'  
N60°E SPIKE AND LIV. CO. REMON TAG IN SOUTH SIDE OF UTILITY POLE 78.60'  
N30°E SPIKE AND LIV. CO. REMON TAG IN SOUTH SIDE OF 14" MAPLE 83.80'

Signed by

Date 10-16-2000

Surveyor's Michigan License No. 35999

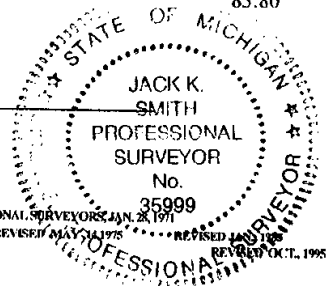

P.A. 345 1990, APPROVED BY LIVINGSTON COUNTY  
PEER GROUP ON 4-19-2000 CO. REP JED

FORM APPROVED BY MICHIGAN STATE BOARD OF PROFESSIONAL SURVEYORS JAN. 2, 1991  
REVISED MAY 1975 REVISED 1981  
REVISED OCT. 1995