


CORNER SUMMARY


A-12: WEST 1/4 COR. SEC. 31, T3N-R4E, HOWELL TWP., LIV. CO. MI

GLO SURVEY DATED APRIL 15, 1825 BY S SIBLEY, DS, AND NONE OF THE GLO WITNESSES REMAIN.

M BULLOCK WITNESSED THIS CORNER IN 1883 AND NONE REMAIN. IN 1972 BOSS ENGR FOUND A 1/2" I. ROD (SAME TODAY) VERY NEAR THE SPLIT OF THE NORTH-SOUTH MILE AND RECORDED AN ACT 74. ONLY ONE OF THEIR WITNESSES REMAIN AND IT CHECKED± WITH A DESINE SURVEY IN 1993; THE REMAINING DESINE WITNESSES CHECK NOW. MEASURED SOUTH 2654.06 BY DESINE, 2653.99 BY MYSELF AND 2657.82 BY OLD CO. SURVEY NOTES. MEASURED NORTH 2653.60 BY ZUHLKE, 2653.44 BY MYSELF AND 2657.82 BY OLD CO. SURVEY NOTES. THE CORNER IS 22.17 FEET NORTH OF THE E 1/4 CORNER SEC. 36 HANDY TWP. (GLO 23.76) AND 0.25 FT. WEST OF A LINE BETWEEN E 1/4 AND NE COR'S OF HANDY TWP. THE CORNER LIES ABOUT 4 FT. WEST OF CENTERLINE OF TRUHN ROAD AND INLINE WITH FENCE LINE REMAINS TO THE EAST. AREA IS OPEN FOR GPS EXCEPT TO THE SW. SET AMENDED CORNER ON THE TOWNSHIP LINE AND LEFT THE CLOSING CORNER AS FOUND.

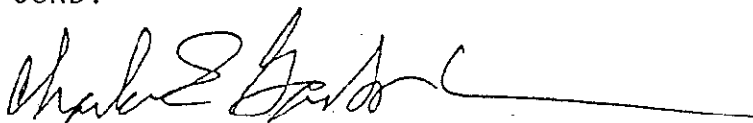

CHARLES E GARLOCK
PS 14762
A12HOW95

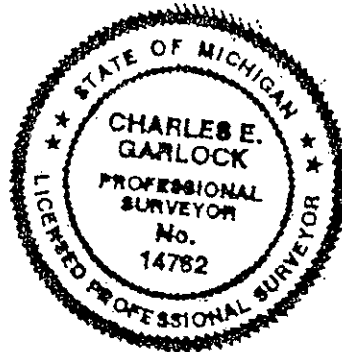

304E A12

4