

SURVEY & REMONUMENTATION

OCT 25 1993

COMMISSION
For corners in
Livingston
(County)

LAND CORNER RECORDATION CERTIFICATE
Filing Requirement of Act 74, Mich. P.A. 1970

OCT 18 9 18 AM '93

NANCY HAVILAND
REGISTER OF DEEDS
LIVINGSTON COUNTY, MI
48843

1. Public Land Survey
2. Property Controlling in Section
3. Miscellaneous Property in Sec.
4. Lot No. , Recorded Plat
5. Private Claims

Located In: T 3N R 4E
Corner Code # A13

C.L.S.# 25m

Register of Deeds Stamp & File Number

I, Charles E Garlock, in a field survey on September 22, 19 93, do hereby certify that under requirements of P.A. 74, Michigan P.A. of 1970, the corner points mentioned in lines 1 and 2 above were in conformance with regulations and rules therefore as required in the current manual of survey instructions of the United States Department of the Interior, Bureau of Land Management or by a decree of a Court of Law and/or that the corner points mentioned in lines 3, 4 and 5 above were in conformance with the rules of the Michigan Board of Land Surveyors or by a Decree of a Court of Law; established, re-established, monumented, re-monumented, recovered, found as expressed below:

NOTE: Not more than 4 corners, all in the same town and range, may be recorded on this certificate.

A. Description of original monument and accessories and/or subsequent restoration:
GLO notes dated: April 15, 1825
GLO witnesses: B0 32-N37W-41 lks
W0 30-S20W-12 lks


See reverse side for summary of research

B. Description of corner evidence found and/or method applied in restoring or reestablishing corner:
Found 3/4" I. Pipe in Mon. Box, 2.5 ft. South of centerline of Mason Road.

C. Description of monument for corner and accessories established to perpetuate locating the position of the corner:
A13; SW corner Sec. 31 T3N-R4E, re-set with 1 1/4" X 36" breakaway I. Pipe with Liv. Co.
Mon, Cor. brass cap on top
S10E-88.24'-sp W/s 10" Poplar
N20E-98.93'-sp W/s 24" Maple
N75E-156.73'-sp S/s U. Pole
North-2.5'-ctr. Mason Road
N70W-56.65'-sp S/s U Pole
West-2'-ctr. Truhn Rd. South
West-10'-ctr. Truhn Rd. North

Approved by Liv. Co. Mon. Peer Group July 21, 1993

Signed by [Signature]
Surveyor's Michigan License No. 14762

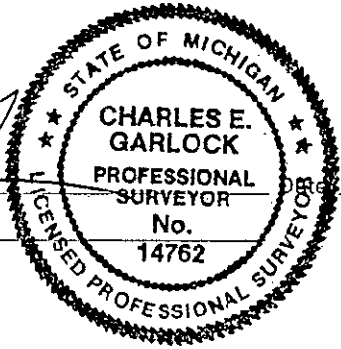

October 16, 1993

10/20/93

SERVING LIVINGSTON COUNTY
SINCE 1888

"Be Sure of Your Ground"

CHARLES E. GARLOCK

PROFESSIONAL SURVEYOR

840 EAST DAVIS ROAD
HOWELL, MICHIGAN 48843

OFFICE: (517) 546-3340

FAX: 517 546-2941


July 12, 1993

A-13; SW corner Section 31 Howell, Twp. Liv. Co. Mi

Oldest known remaining witness is 1968 (L Munsell) and this corner agrees with a 1951 survey by C W Gordeon, in Marion Twp. Since 1951 all known surveys in each Township (Handy, Howell, Iosco and Marion) appear to be tied to the same geographically located corner. Also the average of two old old measures from the SE corner to the S 1/4 corner equals 40.24625 ch. (2656.25 ft.) and the current measure is 2656.18 ft. A sweep of the area found no additional irons and past survey records indicate that it is also a common Township corner.



Charles E Garlock, PS

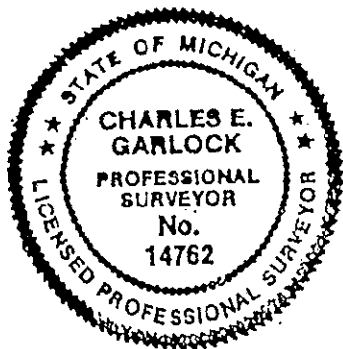

Found 3/4" pinched pipe in Mon. Box on Asphalt Road

SUCCESSOR TO:

MILES W. BULLOCK, L.S. (1844 TO 1926)



GRANT H. DUNNING, P.E. (1865 TO 1928)

CLAY W. GORDON, RLS (1883 TO 1970)



LYLE W. MUNSELL, RLS (1904 TO 1987)