

SURVEY &
REMONUMENTATION

FEB 25 1999

SECTION

LAND CORNER RECORDATION CERTIFICATE
Filing Requirement of Act 74, Mich. P.A. 1970

FILED

For corners in

LIVINGSTON Located In: Corner Code #
(County)

1. Public Land Survey T 3N R 4E G8
T R
T R
T R
T R

2. Property Controlling S T R
in Section S T R
3. Miscellaneous S T R
Property in Sec. S T R

91

1998 AUG 20 P 4: 42

NANCY HAVILAND
REGISTER OF DEEDS
LIVINGSTON COUNTY, MI.
48843

L.S.C. #855m

Register of Deeds Stamp & File Number

4. Lot No. _____, Recorded Plat _____
5. Private Claims _____


I, CHARLES E GARLOCK, in a field survey on AUG. 5, 19 98 do hereby state that under requirements of P.A. 74, Michigan P.A. of 1970, the corner points mentioned in lines 1 and 2 above were in conformance with regulations and rules therefore as required in the current manual of survey instructions of the United States Department of the Interior, Bureau of Land Management or by a decree of a Court of Law and /or that the corner points mentioned in lines 3, 4 and 5 above were in conformance with the rules of the Michigan Board of Land Surveyors or by a Decree of a Court of Law; established, re-established, monumented, recovered, found as expressed below:

NOTE: Not more than 2 corners, all in the same town and range, may be recorded on this certificate.

	A	B	C	D	E	F	G	H	I	J	K	L	M
1													
2	6		5		4		3		2		1		
3													
4	7		8		9		10		11		12		
5													
6	18		17		16		15		14		13		
7													
8	19		20		21		22		23		24		
9													
10	30		29		28		27		26		25		
11													
12	31		32		33		34		35		36		
13													

A. Description of original monument and accessories and/or subsequent restoration:

GLO SURVEY DATED: APRIL 15, 1825 BY S SIBLEY, DS
GLO WITNESSES: WO 9-S58½E-33 LKS
WO 12-N74W-24 LKS.

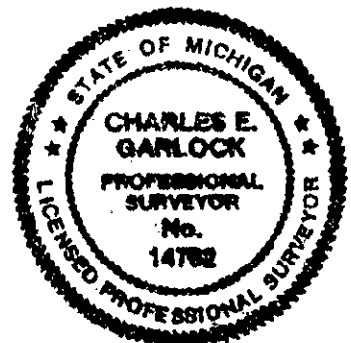

ADDITIONAL DATA ON REAR OF SHEET.

B. Description of corner evidence found and/or method applied in restoring or reestablishing corner:

FOUND ½" I. ROD ON CENTERLINE OF ROAD TO EAST & 2' WEST OF CENTERLINE ROAD NORTH-SOUTH, ALL KNOWN WITNESSES CHECKED WITH THIS POINT. FOUND A SECOND ½" I. ROD S29E-4.53' FROM THE FIRST MENTIONED ½" I. ROD AND NO KNOWN WITNESSES TO THIS POINT OR WHO USED IT. ALL PREVIOUS SURVEYORS APPEAR TO BE USING THE NORTH IRON.

C. Description of monument for corner and accessories established to perpetuate locating the position of the corner:

G9: E ¼ COR. SEC. 21 T3N-R4E, HOWELL TWP. LIV. CO. MI., RESET FOUND ½" I. ROD WITH 1¼" X 36" BREAKAWAY I. PIPE WITH LIV. CO. REMON BRASS CAP ON TOP.
S74E-106.18'-SP & TAGS/S 40" OAK
S57E-68.21'-SP & TAG S/S 8" OAK
S75W-85.88'-SP & TAG N/S 36" OAK
N14W-78.28'-7" WALNUT, SP & TAG OF E/S
(S29E-4.53'-½" I. ROD)

Signed by Charles E. Garlock
Surveyor's Michigan License No. 14762

Date AUGUST 8, 1998

P.A. 345 1990, APPROVED BY LIVINGSTON COUNTY
PEER GROUP ON 3/4/98 CO. REP JED

FORM APPROVED BY MICHIGAN STATE BOARD OF PROFESSIONAL SURVEYORS, JAN. 28, 1971
REVISED MAY 14, 1975
REVISED JAN., 1983
REVISED OCT., 1995