

MAR 17 2000

SECTION

LAND CORNER RECORDATION CERTIFICATE
Filing Requirement of Act 74, Mich. P.A. 1970

FILED

For corners in

LIVINGSTON
(County)

Located In:

Corner Code #

- | | | | |
|------------------------------------|------|------|------|
| 1. Public Land Survey | T 3N | R 5E | G-07 |
| | T | R | |
| | T | R | |
| | T | R | |
| 2. Property Controlling in Section | S | T | R |
| | S | T | R |
| 3. Miscellaneous Property In Sec. | S | T | R |
| | S | T | R |
4. Lot No. _____, Recorded Plat _____
5. Private Claims _____

1999 NOV 22 A 10:07

NANCY HAVILAND
REGISTER OF DEEDS
LIVINGSTON COUNTY, MI.
48843

LSC# 1078m

Register of Deeds Stamp & File Number

I, **MARY A. BARNWELL**, in a field survey on **SEPTEMBER 22, 1999** do hereby state that under requirements of P.A. 74, Michigan P.A. of 1970, the corner points mentioned in lines 1 and 2 above were in conformance with regulations and rules therefore as required in the current manual of survey instructions of the United States Department of the Interior, Bureau of Land Management or by a decree of a Court of Law and for that the corner points mentioned in lines 3, 4 and 5 above were in conformance with the rules of the Michigan Board of Land Surveyors or by a Decree of a Court of Law; established, re-established, monumented, recovered, found as expressed below:

NOTE: Not more than 2 corners, all in the same town and range, may be recorded on this certificate.

A. Description of original monument and accessories and/or subsequent restoration:

G-07 Oceola Township was set by the GLO in 1823.

The original witnesses are:

White Oak 24" S. 50 1/2° W. 2.00 (132.0')

Hickory 8" S. 78° E. 1.37 (90.4')

NOTE: None of the original witnesses could be found or perpetuated.
See the back of this sheet for additional historical data.

B. Description of corner evidence found and/or method applied in restoring or reestablishing corner:

G-07 Found 1/2" Iron Rod in the curve of Brophy Road centerline (gravel surface going West) and Hughes Road (gravel surface going South). The found 1/2" Iron Rod is in the centerline of a gravel 2-track going East, with an old fence going East 33 feet South of the 2-track centerline.


C. Description of monument for corner and accessories established to perpetuate locating the position of the corner:

G-07 Northwest Corner, Section 22, T3N, R5E - Reset 1/2" Iron Rod with 36" x 1 1/4" Breakaway Iron Pipe with Brass Cap marked as "Livingston County Monumentation Corner" 1' South of centerline of road to West and 4' West of centerline of road to South

- S 26° E Set Nail/Remon Washer W/S 38" Oak 45.75'
- S 36° W Set Nail/Remon Washer NW/S 28" Oak 65.52'
- N 06° E Set Nail/Remon Washer E/S 20" Walnut 45.68'
- N 75° E Set Nail/Remon Washer S/S 16" Walnut 51.16'
- N 48° W S.E. Cor. Wildwood Ranch Office Bldg. 57.27'

Signed by

Surveyor's Michigan License No. 33971

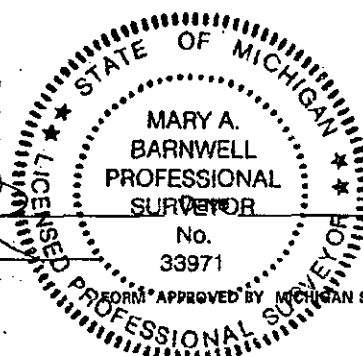

FORM APPROVED BY MICHIGAN STATE BOARD OF PROFESSIONAL SURVEYORS, JAN. 28, 1971
REVISED MAY 14, 1975
REVISED JAN., 1983
REVISED OCT., 1995

PA. 345 1980, APPROVED BY LIVINGSTON COUNTY

PEER GROUP ON 9-1-99 CO. REP JED