

# SURVEY & REMONUMENTATION

JUL 16 1997

COMMISSION

LAND CORNER RECORDATION CERTIFICATE  
Filing Requirement of Act 74, Mich. P.A. 1970

FILED

For corners in

LIVINGSTON

(County)

Located in:

Corner Code #

1. Public Land Survey

T4N R3E

M-7

2. Property Controlling  
in Section

S

T

3. Miscellaneous

S

T

Property in Sec.

S

T

4. Lot No. \_\_\_\_\_, Recorded Plat \_\_\_\_\_

5. Private Claims \_\_\_\_\_

I, CHARLES E. GARLOCK, in a field survey on MAY 19, 1997 do hereby state that under requirements of P.A. 74, Michigan P.A. of 1970, the corner points mentioned in lines 1 and 2 above were in conformance with regulations and rules therefore as required in the current manual of survey instructions of the United States Department of the Interior, Bureau of Land Management or by a decree of a Court of Law and/or that the corner points mentioned in lines 3, 4 and 5 above were in conformance with the rules of the Michigan Board of Land Surveyors or by a Decree of a Court of Law; established, re-established, monumented, recovered, found as expressed below:

NOTE: Not more than 2 corners, all in the same town and range, may be recorded on this certificate.

A. Description of original monument and accessories and/or subsequent restoration:

GLO SURVEY DATED APRIL 15, 1825 BY S SIBLEY AND NONE OF THE GLO WITNESSES REMAIN

GLO WITNESSES: R OAK 16-N29W-42 LKS

W OAK 10-S46W-6 LKS

ADDITIONAL DATA ON REAR OF SHEET.

B. Description of corner evidence found and/or method applied in restoring or reestablishing corner:

FD. 1/2" I. ROD AT -0.2', AT-1.6' FD. 3/4" I. PIPE AND BRICK

C. Description of monument for corner and accessories established to perpetuate locating the position of the corner.

M-7: SE COR. SEC. 13 T4N-R3E, CONWAY TWP. LIV. CO. MI, RESET ABOVE WITH 1 1/4" X 36" BREAK-AWAY I. PIPE WITH LIV. CO. REMON BRASS CAP ON TOP AT -0.5'

N74E-36.46'-SP & TAG S/S 30" OAK

S65E-101.59'-SP & TAG N/S 40" W CHERRY

S32W-41.41'-SP & TAG E.S 24" OAK

N81W-37.27'-SP & TAG S/S 12" WALNUT

EAST-1'-C/L ROAD N & S

SOUTH 6'-C/L ROAD TO EAST

SOUTH-8.50'-T4N-R4E SEC. CORNER


Signed by

*Charles E. Garlock*

Surveyor's Michigan License No.

14762

Date MAY 20, 1997

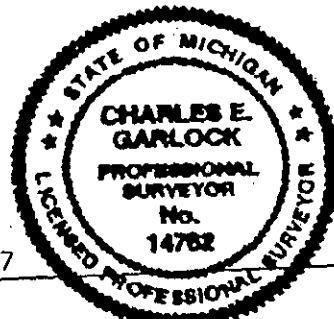

PA. 345 1990, APPROVED BY LIVINGSTON COUNTY

PEER GROUP ON 2/5/1997 CO. REP JED

FORM APPROVED BY MICHIGAN STATE BOARD OF PROFESSIONAL SURVEYORS, JAN. 28, 1971  
REVISED MAY 14, 1975  
REVISED JAN., 1983  
REVISED OCT., 1995

*"Be Sure of Your Ground"*

**CHARLES E. GARLOCK**

PROFESSIONAL SURVEYOR

705 N. MICHIGAN AVE.

HOWELL, MICHIGAN 48843

OFFICE: (517) 546-3340

FAX: 517 546-2941

DECEMBER 28, 1996

**CORNER SUMMARY**

M-7: SE CORNER SECTION 13, T4N-R3E, CONWAY TWP. LIV. CO. MI

GLO SURVEY DATED APRIL 15, 1825 BY S SIBLEY, DS, AND NONE OF THE GLO WITNESSES REMAIN.

M BULLOCKS 1874 WITNESS IS GONE. NEXT KNOWN ACTIVITY WAS 1986 WHEN D HUGHES AND BOSS ENGR WERE AT THE CORNER, HUGHES FOUND A 1/2" I ROD WITH A BOSS CAP AND THE REMAINING WITNESSES BY BOTH FIRMS CHECK. B THOMPSON IN 1993 ALSO FOUND A 1/2" I ROD AND HIS WITNESSES CHECKED TO THE SAME POINT. HUGHES FOUND THE COHOCTAH CORNER 8.50 FEET SOUTH, A RR SPIKE, AS I DID IN 1995. WE FOUND A 1/2" I. ROD IN '96 AND ALL OF THE ABOVE WITNESSES CHECKED AS DID THE MEASURE SOUTH TO THE COHOCTAH CORNER. M-7 IS 3 FEET WEST OF THE CENTERLINE OF THE NORTH-SOUTH ROAD AND 6 FEET NORTH OF THE CENTERLINE OF MAXWELL ROAD TO THE EAST, IT ALSO LINES WITH A FENCE LINE TO THE WEST. MARGINAL FOR A GPS SITE. ONE ACT 74 RECORDED BY B THOMPSON. WE MEASURED NORTH 2664.28 AND HUGHES HAD 2664.21. SOUTH WE HAD 2639.82 AND BOSS HAD 2639.77, RECOMMEND CONTINUED USE OF THE FOUND CORNER.



CHARLES E. GARLOCK, PS

CON97M7

**SUCCESSOR TO:**

MILES W. BULLOCK, L.S. (1844 TO 1926) ●

GRANT H DUNNING, P.E. (1865 TO 1928)

CLAY W. GORDON, RLS (1883 TO 1970) ●

LYLE W. MUNSELL, RLS (1904 TO 1987)

4N3E  
M7  
4