

SURVEY & REMONUMENTATION

FEB 26 2001

FILED

SECTION

LAND CORNER RECORDATION CERTIFICATE Filing Requirement of Act 74, Mich. P.A. 1970

For corners in

<u>LIVINGSTON</u> (County)	Located In:	Corner Code #
1. Public Land Survey	T 4 N R 3 E	K-06
	T R	
	T R	
	T R	
2. Property Controlling in Section	S T R	
	S T R	
3. Miscellaneous Property in Sec.	S T R	
	S T R	

2000 SEP 28 A 9:18

NANCY HAVILAND
REGISTER OF DEEDS
LIVINGSTON COUNTY, MI.
48843

LSC #1289m
Register of Deeds Stamp & File Number

4. Lot No. _____, Recorded Plat _____
5. Private Claims _____

I, JACK K. SMITH, in a field survey on JULY 20, 2000 do hereby state that under requirements of P.A. 74, Michigan P.A. of 1970, the corner points mentioned in lines 1 and 2 above were in conformance with regulations and rules therefore as required in the current manual of survey instructions of the United States Department of the Interior, Bureau of Land Management or by a decree of a Court of Law and /or that the corner points mentioned in lines 3, 4 and 5 above were in conformance with the rules of the Michigan Board of Land Surveyors or by a Decree of a Court of Law; established, re-established, monumented, recovered, found as expressed below:

NOTE: Not more than 2 corners, all in the same town and range, may be recorded on this certificate.

A. Description of original monument and accessories and/or subsequent restoration:

GLO, SURVEY DATED: APRIL 15, 1825 BY S. SIBLEY
GLO WITNESSES: SUGAR 20" N15°W 17.82'
PINE 18" N27 1/2°E 77.22'

B. Description of corner evidence found and/or method applied in restoring or reestablishing corner:

FOUND RAILROAD SPIKE ON C/L OF HAYNER ROAD AND 2' +/- WEST OF C/L OF ROBB ROAD TO THE SOUTH.

C. Description of monument for corner and accessories established to perpetuate locating the position of the corner:


K-06: EAST 1/4 CORNER OF SECTION 14, T4N-R3E, CONWAY TOWNSHIP, LIVINGSTON COUNTY, MICHIGAN. SET 1 1/4" X 36" BREAKAWAY STEEL PIPE WITH LIVINGSTON COUNTY REMON BRASS CAP # 35999 IN MON. BOX.

S50°E	SP & LIV. COUNTY REMON. TAG ON THE S.W. SIDE OF A 12" OAK	49.67'
S10°E	SP & LIV. COUNTY REMON. TAG ON THE WEST SIDE OF A 49" OAK	172.45'
S30°W	SP & LIV. COUNTY REMON. TAG ON THE EAST SIDE OF A UTILITY POLE	160.83'
N02°W	SP & LIV. COUNTY REMON. TAG ON THE EAST SIDE OF A 36" OAK	43.61'

Signed by

Date JULY 20, 2000

Surveyor's Michigan License No. 35999

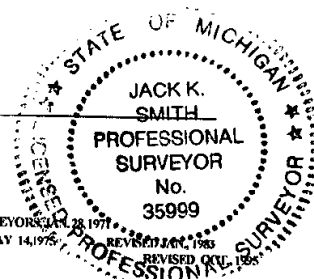

FORM APPROVED BY MICHIGAN STATE BOARD OF PROFESSIONAL SURVEYORS JAN 28 1977

REVISED MAY 14, 1975 REVISED JULY 20, 1983 REVISED OCT. 1985

PA. 345 1960, APPROVED BY LIVINGSTON COUNTY

PEER GROUP ON 2-16-2000, CO. REP JED