

SURVEY & REMONUMENTATION

FEB 26 2001

SECTION

LAND CORNER RECORDATION CERTIFICATE
Filing Requirement of Act 74, Mich. P.A. 1970

FILED

For corners in

LIVINGSTON
(County)

Located In:

Corner Code #

2000 SEP 28 1 A 9:18

NANCY HAVILAND
REGISTER OF DEEDS
LIVINGSTON COUNTY, MI.
48843

1. Public Land Survey

T 4 N R 3 E

L-05

T R

T R

T R

2. Property Controlling
in Section

S

T R

S

T R

3. Miscellaneous
Property in Sec.

S

T R

S

T R

LSC #1290m

Register of Deeds Stamp & File Number

4. Lot No. _____, Recorded Plat _____

5. Private Claims _____

I, JACK K. SMITH, in a field survey on JULY 20, 2000, do hereby state that under requirements of P.A. 74, Michigan P.A. of 1970, the corner points mentioned in lines 1 and 2 above were in conformance with regulations and rules therefore as required in the current manual of survey instructions of the United States Department of the Interior, Bureau of Land Management or by a decree of a Court of Law and/or that the corner points mentioned in lines 3, 4 and 5 above were in conformance with the rules of the Michigan Board of Land Surveyors or by a Decree of a Court of Law; established, re-established, monumented, recovered, found as expressed below:

NOTE: Not more than 2 corners, all in the same town and range, may be recorded on this certificate.

A. Description of original monument and accessories and/or subsequent restoration:

GLO, SURVEY DATED: APRIL 15, 1825 BY S. SIBLEY
GLO WITNESSES: BLACK ASH 8" N86°E 17.16'
BLACK ASH 6" S83°W 7.26'

B. Description of corner evidence found and/or method applied in restoring or reestablishing corner:

THE EXISTING CORNER IS A 1/2" IRON ROD WITH CAP # 12024 ON THE SOUTH EDGE OF A RAILROAD TIE FENCE CORNER POST. THERE ARE FENCE LINES TO THE NORTH, SOUTH EAST AND WEST.

C. Description of monument for corner and accessories established to perpetuate locating the position of the corner:


L-05: NORTH 1/4 CORNER OF SECTION 13, T4N-R3E, CONWAY TOWNSHIP, LIVINGSTON COUNTY, MICHIGAN.
SET 1 1/4" X 36" STEEL PIPE WITH LIVINGSTON COUNTY REMON BRASS CAP # 35999 IN PLACE OF THE FOUND REROD.

NORTH SP & LIV. COUNTY REMON. TAG ON THE WEST SIDE OF A 24" MAPLE 24.78'
SOUTH SP & LIV. COUNTY REMON. TAG ON THE WEST SIDE OF A 12" ASH 46.21'
S45°W SP & LIV. COUNTY REMON. TAG ON THE NORTH SIDE OF A 6" ASH 47.47'
S60°W SP & LIV. COUNTY REMON. TAG ON THE WEST SIDE OF A 6" MAPLE 37.97'

Signed by

Date JULY 20, 2000

Surveyor's Michigan License No. 35999

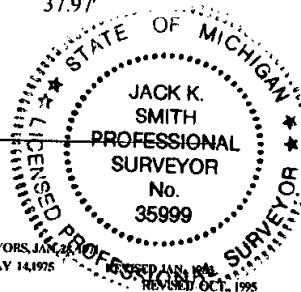

FORM APPROVED BY MICHIGAN STATE BOARD OF PROFESSIONAL SURVEYORS, JAN. 2000
REVISED MAY 14, 1975
REVISED JUN. 1984
REVISED OCT. 1995

P.A. 345 1990, APPROVED BY LIVINGSTON COUNTY

PEER GROUP ON 2-16-2000 CO. REP JED