

MAR 17 2000

FILED

SECTION

LAND CORNER RECORDATION CERTIFICATE

Filing Requirement of Act 74, Mich. P.A. 1970

1999 SEP 10 A 9:05

NANCY HAVILAND
REGISTER OF DEEDS
LIVINGSTON COUNTY, MI.
48843

or corners in

Livingston Located In: Corner Code #
(County)

Public Land Survey T 4N R 4E I-9
Property Controlling S T R
in Section S T R
Miscellaneous S T R
Property in Sec. S T R

LSC# 1059m

Register of Deeds Stamp & File Number

Lot No. Recorded Plat
Private Claims

John H. Rauser, P.S., in a field survey on August 19 99
hereby certify that under requirements of P.A. 74, Michigan P.A. of 1970, the corner points mentioned
lines 1 and 2 above were in conformance with regulations and rules therefore as required in the
rent manual of survey instructions of the United States Department of the Interior, Bureau of Land
anagement or by a decree of a Court of Law and/or that the corner points mentioned in lines 3, 4 and 5
ove were in conformance with the rules of the Michigan Board of Land Surveyors or by a Decree of a
urt of Law; established, re-established, monumented, re-monumented, recovered, found as
pressed below:

OTE: Not more than 2 corners, all in the same town and range, may be recorded on this
certificate.

Description of original monument and accessories and/or subsequent restoration:

Common Corner, Sections 22, 23, 26, & 27, T4N-R4E

1823 Wood post placed by Sylvester Sibley, D.S.
N67E 13 lks (8.58') 8" Spruce
South 17 lks (11.22') 7" Spruce

(Additional information on back)

Description of corner evidence found and/or method applied in restoring or reestablishing corner:

Common Corner, Sections 22, 23, 26, & 27, T4N-R4E


Found re-rod with cap # 12024 driven into the side of a wood corner post. Post was found lying on the ground. Reset
corner monument in the record position using the recorded witnesses from 1973.

Description of monument for corner and accessories established to perpetuate locating the position of the corner:

Common Corner, Sections 22, 23, 26, & 27, T4N-R4E

Standard Livingston County Remon monument with brass cap.

N20W 32.50' Measured to SE face of a dead Oak tree
N .40" Set 5' Carsonite Marker Post near dead wooden fencepost.
S80E 17.50' Set spike/tag in S. face of 4" Elm with Livingston County Remon tag
S20W 23.40' Set spike with Livingston County Remon tag in E. face of 8" Maple tree
S45W 24.30' Measured to center of a tree stump
S88W 19.10' Set spike with Livingston County Remon tag in S. face of 5" Maple tree

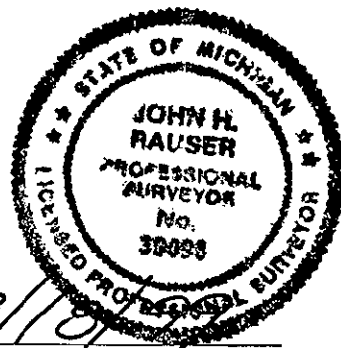

igned by John H. Rauser
urveyor's Michigan License No. 39096

Date 9/10/99

FORM APPROVED BY MICHIGAN STATE BOARD OF LAND SURVEYORS, JAN. 28, 1971

P.A. 345 1990, APPROVED BY LIVINGSTON COUNTY

PEER GROUP ON 8.4.99 CO. REP JED

REVISÉ MAY 14, 1976
REVISÉ JAN., 1983
ADAPTED FOR WORD PROCESSING MARCH, 1993