

SURVEY &
REMONUMENTATION

FEB 25 1999

SECTION

FILED

1998 REMONUMENTATION PROGRAM
LAND CORNER RECORDATION CERTIFICATE
Filing Requirement of Act 74, Mich. P.A. 1970

1998 OCT 14 P 2:11

NANCY HAVILAND
REGISTER OF DEEDS
LIVINGSTON COUNTY, MI.
48843

or corners in

Livingston
(County)

Located In:

Corner Code #

LSC 912M

Public Land Survey T 4N R 4E L 9
Property Controlling S T R
In Section S T R
Miscellaneous S T R
Property In Sec. S T R

Register of Deeds Stamp & File Number

Lot No. , Recorded Plat
Private Claims

John H. Rauser, P.S., in a field survey on September 1998
I hereby certify that under requirements of P.A. 74, Michigan P.A. of 1970, the corner points mentioned
lines 1 and 2 above were in conformance with regulations and rules therefore as required in the
current manual of survey instructions of the United States Department of the Interior, Bureau of Land
Management or by a decree of a Court of Law and/or that the corner points mentioned in lines 3, 4 and 5
above were in conformance with the rules of the Michigan Board of Land Surveyors or by a Decree of a
Court of Law; established, re-established, monumented, re-monumented, recovered, found as
expressed below:

NOTE: Not more than 2 corners, all in the same town and range, may be recorded
on this certificate.

	A	B	C	D	E	F	G	H	I	J	K	L	M
1													
2	6	5	4	3	2	1							
3													
4	7	8	9	10	11	12							
5													
6	18	17	16	15	14	13							
7													
8	19	20	21	22	23	24							
9													
10	30	29	28	27	26	25							
11													
12	31	32	33	34	35	36							
13													

Description of original monument and accessories and/or subsequent restoration:

-9 Common 1/4 Corner, Sections 24 & 25, T4N-R4E, Cohoctah Township, Livingston County

1823 Wood post placed by John Mullett, D.S.: Spruce 14" S64W 13 lks
Spruce 12" S85E 19 lks

(Additional information on back)

Description of corner evidence found and/or method applied in restoring or reestablishing corner:

-9 Common 1/4 Corner, Sections 24 & 25, T4N-R4E, Cohoctah Township, Livingston County

Found a concrete monument broken and leaning with an aluminum cap stamped "#18655 D.L.B".

Description of monument for corner and accessories established to perpetuate locating the position of the corner:

-9 Common 1/4 Corner, Sections 24 & 25, T4N-R4E, Cohoctah Township, Livingston County


Replaced recovered concrete monument in poor condition with Standard Livingston County Remon iron pipe with brass cap.

N30W 7.71' Fnd DNR ref tag in NE fc 10" Cherry
N19W 12.65' Set remon witness tag above grown in DNR ref tag in NE fc 10" Cherry
S52W 25.51' Set remon witness tag in SE fc 8" Maple
S20W 26.59' Set remon witness tag in E fc 10" Maple

igned by John H. Rauser
urveyor's Michigan License No. 39096

Date

FORM APPROVED BY MICHIGAN STATE BOARD OF LAND SURVEYORS

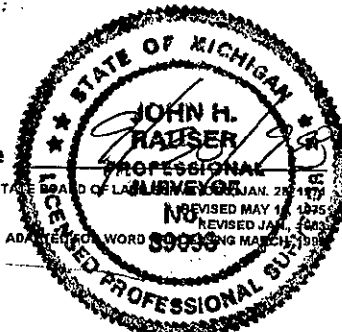

P.A. 345 1980, APPROVED BY LIVINGSTON COUNTY
PEER GROUP ON 7-15-98 CO. REP JED