

MAR 17 2000

SECTION

LAND CORNER RECORDATION CERTIFICATE
Filing Requirement of Act 74, Mich. P.A. 1970

FILED

1999 NOV 22 A 10:08

NANCY HAVILAND
REGISTER OF DEEDS
LIVINGSTON COUNTY, MI.
48843

For corners in

LIVINGSTON
(County)

Located In:

Corner Code #

1. Public Land Survey

T 4N R 5E I-10

2. Property Controlling
in Section

S T R

3. Miscellaneous
Property in Sec.

S T R

4. Lot No. , Recorded Plat

5. Private Claims

JSC# 1094m

Register of Deeds Stamp & File
Number

I, MARY A. BARNWELL, in a field survey on SEPTEMBER 29, 1999 do hereby state that under requirements of P.A. 74, Michigan P.A. of 1970, the corner points mentioned in lines 1 and 2 above were in conformance with regulations and rules therefore as required in the current manual of survey instructions of the United States Department of the Interior, Bureau of Land Management or by a decree of a Court of Law and/or that the corner points mentioned in lines 3, 4 and 5 above were in conformance with the rules of the Michigan Board of Land Surveyors or by a Decree of a Court of Law; established, re-established, monumented, recovered, found as expressed below:

NOTE: Not more than 2 corners, all in the same town and range, may be recorded on this certificate.

	A	B	C	D	E	F	G	H	I	J	K	L	M
1													
2	6	5	4	3	2	1							
3													
4	7	8	9	10	11	12							
5													
6	18	17	16	15	14	13							
7													
8	19	20	21	22	23	24							
9													
10	30	29	28	27	26	25							
11													
12	31	32	33	34	35	36							
13													

A. Description of original monument and accessories and/or subsequent restoration:

I-10 Deerfield Township was set by the GLO in 1823.
The original witnesses are:

Elm 6" S 10° E 48 Links (31.7')

Black Ash 7" N 77 1/2° E 23 Links (15.2')

NOTE: None of the original witnesses could be found or perpetuated.
See the back of this sheet for additional historical data.

B. Description of corner evidence found and/or method applied in restoring or reestablishing corner:

I-10 Found Railroad Spike 2 feet West of the centerline of Argentine Road (asphalt surface running North/South) - No well-defined old occupation running East or West.

C. Description of monument for corner and accessories established to perpetuate locating the position of the corner:

I-10 West 1/4 Corner, Section 26, T4N, R5E - Reset Railroad Spike with 36" x 1 1/4" steel breakaway pipe with Brass Cap marked as "Livingston County Monumentation Corner" in new Monument Box

N 85° E Set Nail/Remon Washer N/S 18" Elm 88.24'


N 72° W Set Nail/Remon Washer N/S P. Pole 50.93'

S 53° W Set Nail/Remon Washer N/S 24" Oak 87.99'

S 19° W Set Nail/Remon Washer NW/S 30" Box Elder 104.17'

Signed by

Surveyor's Michigan License No. 33971

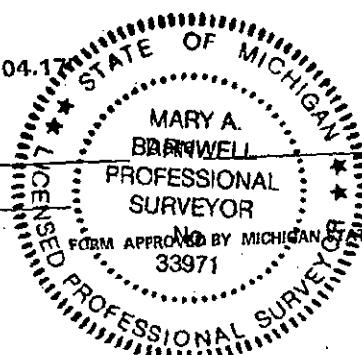

P.A. 345 1990, APPROVED BY LIVINGSTON COUNTY
8-4-99 CO REP JED

FORM APPROVED BY MICHIGAN STATE BOARD OF PROFESSIONAL SURVEYORS, JAN. 28, 1971
REVISED MAY 14, 1975
REVISED JAN., 1983
REVISED OCT., 1995