

SURVEY & REMONUMENTATION

FEB 26 2001

FILED

LAND CORNER RECORDATION CERTIFICATE

SECTION

Filing Requirement of Act 74, Mich. P.A. 1970

2000 OCT 30 1A 9:20

For corners in

HANGY HAVILAND
REGISTER OF DEEDS
LIVINGSTON COUNTY, MI.
48843

Livingston Located In: Corner Code #
(County)

1. Public Land Survey T 4N R 5E G-10
T R
2. Property Controlling S T R
in Section S T R
3. Miscellaneous S T R
Property in Sec. S T R

LSC #1324m

Register of Deeds Stamp & File Number

4. Lot No. , Recorded Plat
5. Private Claims

I, John H. Rauser, P.S., in a field survey on Jacy 2000
do hereby certify that under requirements of P.A. 74, Michigan P.A. of 1970, the corner points mentioned in lines 1 and 2 above were in conformance with regulations and rules therefore as required in the current manual of survey instructions of the United States Department of the Interior, Bureau of Land Management or by a decree of a Court of Law and/or that the corner points mentioned in lines 3, 4 and 5 above were in conformance with the rules of the Michigan Board of Land Surveyors or by a Decree of a Court of Law; established, re-established, monumented, re-monumented, recovered, found as expressed below:

NOTE: Not more than 2 corners, all in the same town and range, may be recorded on this certificate.

	A	B	C	D	E	F	G	H	I	J	K	L	M
1													
2	6	5	4	3	2	1							
3													
4	7	8	9	10	11	12							
5													
6	18	17	16	15	14	13							
7													
8	19	20	21	22	23	24							
9													
10	30	29	28	27	26	25							
11													
12	31	32	33	34	35	36							
13													

A. Description of original monument and accessories and/or subsequent restoration:

G-10 1/4 corner common to Sections 27 & 28, T4N-R5E, Deerfield Township, Livingston County, Michigan.
1823 Wood post placed by Sylvester Sibley, D.S.: Hickory 8" N01E 38 lks (25.08')
Oak 34" S12W 26 lks (17.16')
1972 Act 132 by O. Boss, L.595, P.593; fnd iron.
West 28.50' 8" square conc. fence post
S38W 68.60' Spike in Triple 8" Oak
S62E 57.40' Spike in 12" Oak
1972 Act 74 by O. Boss, LSC #315; same as above.
1987 Unrecorded Survey by D.W. Ross; fnd bent iron bar, set nail. Listed same witnesses as above.
(Continued on Back.)

B. Description of corner evidence found and/or method applied in restoring or reestablishing corner:

G-10 1/4 corner common to Sections 27 & 28, T4N-R5E, Deerfield Township, Livingston County, Michigan.
Found no evidence of original government corner. Found 1/2" iron five feet East of centerline of Mack Road. Occupation to the West is a fence line along a tree row. Verified the position of the 1/2" iron with record witnesses and measurements from 1972 to present. The position agrees with existing occupation West. Found no conflicting evidence in the vicinity of this position. We recommend that the found 1/2" iron be accepted as the best available evidence of the position of the original government corner and be replaced with a standard Livingston County breakaway monument and brass cap.

C. Description of monument for corner and accessories established to perpetuate locating the position of the corner:


G-10 1/4 corner common to Sections 27 & 28, T4N-R5E, Deerfield Township, Livingston County, Michigan.
Set standard Livingston County breakaway monument and brass cap stamped "G-10 39096".
East 32.64' Found 1/2" rod (R=32.65')
East 23.41' Found Boss N&T in North face of 11" Oak (R=23.42')
West 28.64' Face of 8" square concrete fence post - measured to SE corner at ground (R=28.50')
N80W 27.85' Found nail in East face of 12" Oak (R=27.84')
S70W 37.44' Found Boss N&T in North face of multi-stem Oak (R=37.42')

Signed by

Surveyor's Michigan License No. 39096

P.A. 345 1990, APPROVED BY LIVINGSTON COUNTY

PEER GROUP ON 5-17-00 CO. REP JCD

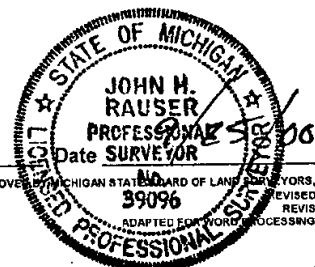

FORM APPROVED BY MICHIGAN STATE BOARD OF LAND SURVEYORS, JAN. 26, 1971
REVISED MAY 14, 1971
REVISED JAN., 1982
ADAPTED FOR WORD PROCESSING MARCH, 1992