

MAR 17 2000

SECTION

LAND CORNER RECORDATION CERTIFICATE
Filing Requirement of Act 74, Mich. P.A. 1970

FILED

For corners in
LIVINGSTON
(County)

Located in: TYRONE

Corner Code #

9

NOV 22 A 11:10

NANCY HAVILAND
REGISTER OF DEEDS
LIVINGSTON COUNTY, MI.
46843

1. Public Land Survey T 4N R 6E E-9
T R
T R
T R
2. Property Controlling in Section S T R
S T R
3. Miscellaneous S T R
Property In Sec. S T R

LSC# 1130m

Register of Deeds Stamp and File Number

4. Lot No. , Recorded Plat
5. Private Claims

I, Bryan L. Boss, in a field survey on NOV. 8, 1999

do hereby certify that under requirements of P.A. 74, Michigan P.A. of 1970, the corner points mentioned in lines 1 and 2 above were in conformance with regulations and rules therefor as required in the current manual of survey instructions of the United States Department of the Interior, Bureau of Land Management or by a decree of a Court of Law and/or that the corner points mentioned in lines 3, 4 and 5 above were in conformance with the rules of the Michigan Board of Land Surveyors or by a Decree of a Court of Law; established, re-established, monumented, re-monumented, recovered, found as expressed below.

NOTE: Not more than 4 corners, all in the same town and range, may be recorded on this certificate.

A. Description of original monument and accessories and/or subsequent restoration:


SET POST
8" W. OAK N52°E 58 LINKS
16" W. OAK S19°W 125 LINKS

B. Description of corner evidence found and/or method applied in restoring or reestablishing corner:

FOUND R.R. SPIKE 2.4' EAST OF CENTERLINE OF OLD US 23

C. Description of monument for corner and accessories established to perpetuate locating the position of the corner:

SET 1 1/4" X 30" PIPE CONNECTED BY PLASTIC
PIPE INSERTED IN A 1 1/4" X 6" PIPE WITH A
BRASS CAP STAMPED "LIVINGSTON COUNTY
REMONUMENTATION CORNER" IN A MON BOX
S12°W 242.95' SET REMON NAIL & TAG E/S 6" ASH N77°W 144.81' SET REMON NAIL & TAG S/S TWIN
S59°W 98.63' SET REMON NAIL & TAG E/S POWER CHERRY
POLE S75°W 56.55' BASE OF STOP SIGN
S89°W 298.67' SET REMON NAIL & TAG N/S MULTI
STEM OAK

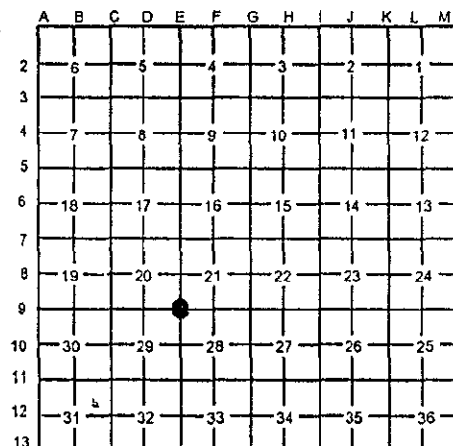

P.A. 345 1990, APPROVED BY LIVINGSTON COUNTY

PEER GROUP ON 5-19-99 CO. REP JED



Signed by *Bryan L. Boss*

Date NOV. 11, 1999

Surveyor's Michigan License No. 29238