

MAR 17 2000

FILED

SECTION

LAND CORNER RECORDATION CERTIFICATE
Filing Requirement of Act 74, Mich. P.A. 1970

For corners in
LIVINGSTON

(County)

Located in: TYRONE

Corner Code #

9

1999 NOV 22 A 11:10

NANCY HAVILAND
REGISTER OF DEEDS
LIVINGSTON COUNTY, MI.
48843

LSC# 1133m

Register of Deeds Stamp and File Number

- | | | |
|------------------------------------|-----------|-----|
| 1. Public Land Survey | T 4N R 6E | G-9 |
| | T R | |
| | T R | |
| | T R | |
| 2. Property Controlling in Section | S T R | |
| | S T R | |
| 3. Miscellaneous Property in Sec. | S T R | |
| | S T R | |

4. Lot No. , Recorded Plat
5. Private Claims

I, Bryan L. Boss, in a field survey on SEPT. 28, 1999

do hereby certify that under requirements of P.A. 74, Michigan P.A. of 1970, the corner points mentioned in lines 1 and 2 above were in conformance with regulations and rules therefor as required in the current manual of survey instructions of the United States Department of the Interior, Bureau of Land Management or by a decree of a Court of Law and/or that the corner points mentioned in lines 3, 4 and 5 above were in conformance with the rules of the Michigan Board of Land Surveyors or by a Decree of a Court of Law; established, re-established, monumented, re-monumented, recovered, found as expressed below.

NOTE: Not more than 4 corners, all in the same town and range, may be recorded on this certificate.

A. Description of original monument and accessories and/or subsequent restoration:

SET POST
12" POPLAR N1°E 136L
12" Y. OAK N48°W 175 L

B. Description of corner evidence found and/or method applied in restoring or reestablishing corner:

FOUND 1" PIPE 7 FT SOUTH OF CENTERLINE GORDON ROAD AND
ON CENTERLINE OF HARTLAND ROAD

C. Description of monument for corner and accessories established to perpetuate locating the position of the corner:


SET 1 1/4" X30" PIPE WITH 1 1/4"X6" BREAKAWAY
PIPE ABOVE WITH BRASS CAP STAMPED
"LIVINGSTON COUNTY REMONUMENTATION
CORNER"

N10°E 19.13' SET REMON NAIL&TAG W/S TWIN
OAK

S16°E 73.90' SET REMON NAIL &TAG SE/S
TELEPHONE POLE

S58°W 68.50' SET REMON NAIL&TAG NW/S
POWER POLE

N67°W 108.54' SET REMON NAIL & TAG S/S 16"
OAK

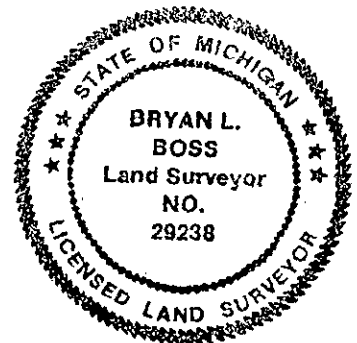

P.A. 345 1990, APPROVED BY LIVINGSTON COUNTY
PEER GROUP ON 5-19-99 CO. REP JED

Signed by *Bryan L. Boss*

Date NOV. 9, 1999

Surveyor's Michigan License No. 29238