

FEB 25 1999

**FILED**

**SECTION**

**LAND CORNER RECORDATION CERTIFICATE**

Filing Requirement of Act 74, Mich. P.A. 1970

1998 OCT 22 P 1:17

For corners in

Livingston  
(County)

Located In:

Corner Code //

NANCY HAVILAND  
REGISTER OF DEEDS  
LIVINGSTON COUNTY, MI.  
48843

LSC946M

Register of Deeds Stamp & File Number

- |                                       |                         |            |
|---------------------------------------|-------------------------|------------|
| 1. Public Land Survey                 | T <u>4N</u> R <u>6E</u> | <u>K-5</u> |
|                                       | T _____ R _____         | _____      |
|                                       | T _____ R _____         | _____      |
|                                       | T _____ R _____         | _____      |
| 2. Property Controlling<br>in Section | S _____ T _____ R _____ | _____      |
|                                       | S _____ T _____ R _____ | _____      |
| 3. Miscellaneous<br>Property in Sec.  | S _____ T _____ R _____ | _____      |
|                                       | S _____ T _____ R _____ | _____      |

4. Lot No. \_\_\_\_\_, Recorded Plat \_\_\_\_\_
5. Private Claims \_\_\_\_\_

I, Bryan L. BOSS, in a field survey on September 24, 19 98, do hereby certify that under requirements of P.A. 74, Michigan P.A. of 1970, the corner points mentioned in lines 1 and 2 above were in conformance with regulations and rules therefore as required in the current manual of survey instructions of the United States Department of the Interior, Bureau of Land Management or by a decree of a Court of Law and/or that the corner points mentioned in lines 3, 4 and 5 above were in conformance with the rules of the Michigan Board of Land Surveyors or by a Decree of a Court of Law: established, re-established, monumented, re-monumented, recovered, found as expressed below:

**NOTE:** Not more than 4 corners, all in the same town and range, may be recorded on this certificate.

A. Description of original monument and accessories and/or subsequent restoration:


Set post 1823  
White Oak 12" N 20 E 13 L  
Black Oak 7" S 64 W 22 L.

B. Description of corner evidence found and/or method applied in restoring or reestablishing corner:

Found Railroad spike in mon. box

**P.A. 345 1980, APPROVED BY LIVINGSTON COUNTY**  
**PEER GROUP ON 8-19-98 CO. REP JED**

- C. Description of monument for corner and accessories established to perpetuate locating the position of the corner:
- Set 30" by 1½" pipe W/6" breakaway & Brass cap Stamped  
"Livingston County Monumentation Corner" in existing monument box  
N 45 W 57.00 set Remon N/T W/S 12" Elm  
West 22.31 set Remon N/T N/S pole  
S 80 E. 46.40' set Remon N/T N/S 46" Oak  
N 45 E 54.52 set Remon N/T W/S 20" Oak

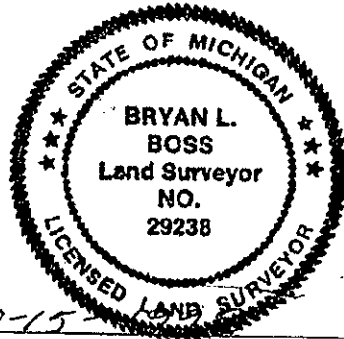

Signed by Bryan L. Boss

Date 10-15

Surveyor's Michigan License No. 29238