

LAND CORNER RECORDATION CERTIFICATE

Filing Requirement of Act 74, Mich. P.A. 1970

For corners in

Mackinac
(County)

Located In:

Corner Code #

1. Public Land Survey T 41N R 4W F-1
T _____ R _____
T _____ R _____
T _____ R _____
2. Property Controlling S _____ T _____ R _____
in Section S _____ T _____ R _____
3. Miscellaneous S _____ T _____ R _____
Property in Section S _____ T _____ R _____
4. Lot No. _____, Recorded Plat _____
5. Private Claims _____

RECEIVED & FILED
DIANE FRANKOVICH
MACKINAC COUNTY REGISTRE. OF DEEDSNOV 7 5 1996
AM PM
7|8|9|10|11|12|1|2|3|4|5|6

Register of Deeds Stamp & File Number

	A	B	C	D	E	F	G	H	I	J	K	L	M
2	6		5		4		3		2		1		
3													
4	7		6		5		4		3		2		1
5													
6	18		17		16		15		14		13		
7													
8	19		20		21		22		23		24		
9													
10	30		29		28		27		26		25		
11													
12	31		32		33		34		35		36		
13													

I, David B. Guthrie in a field survey on April 17, 1996,
do hereby certify that under requirements of P.A. 74, Michigan P.A. of 1970, the corner points mentioned
in lines 1 and 2 above were in conformance with regulations and rules therefore as required in the current
manual of survey instructions of the United States Department of the Interior, Bureau of Land
Management or by a decree of a Court of Law and/or that the corner points mentioned in lines 3, 4 and
5 above were in conformance with the rules of the Michigan Board of Professional Surveyors or by a
Decree of a Court of Law; established, re-established, monumented, re-monumented, recovered, found
as expressed below:

NOTE: Not more than 4 corners, all in the same town and range, may be recorded
on this certificate.

A. Description of original monument and accessories and/or subsequent restoration:

No record of this corner being set at the time of the G.L.O. Survey.

1986: Survey by MDOT - Set 1/2" Iron Rod bet. sec. cors. to E-W (Closing Corners)

B. Description of corner evidence found and/or method applied in restoring or reestablishing corner:

1996: Found 1/2" Iron Rod.

SURVEY &
REMONUMENTATION

MAY 20 1997


COMMISSION

ACCEPTED BY THE MACKINAC COUNTY
SURVEY PEER GROUP AS THE
OFFICIAL CORNER UNDER P.A.
345 OF 1990 AT A MEETING
HELD ON 8-20-96*James H. Granger*

C. Description of monument for corner and accessories established to perpetuate locating the position of the corner:

1996: Set a 5/8" x 24" Iron Rod with an Aluminum Cap stamped to identify the
corner 6" below the road surface.

Referenced: N80°W - Stop Sign Post - 81.87 Feet
S15°E - Utility Pole - 32.47 Feet
N20°E - Utility Pole - 38.95 Feet
S17°E - Utility Pole - 33.00 Feet
N30°E - S.W. Cor. Hse. - 110.50 Feet

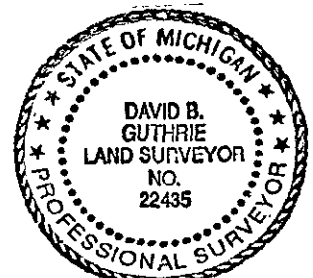

Signed by

David B. Guthrie

Date

Oct. 1, 1996Surveyor's Michigan License No. 22435FORM APPROVED BY MICHIGAN STATE BOARD OF PROFESSIONAL SURVEYORS, JAN. 28, 1971
REVISED MAY 14, 1975
REVISED JAN., 1993

E 0072