

LAND CORNER RECORDATION CERTIFICATE  
Filing Requirement of Act 74, Mich. P.A. 1970

MAR 20 2000

Mackinac County Remonumentation Corner

SECTION

For corners in

Mackinac County

Located in:

Corner Code #

- |                         |   |      |      |               |
|-------------------------|---|------|------|---------------|
| 1. Public Land Survey   |   | T41N | R04W | K-3           |
|                         |   | T    | R    |               |
|                         |   | T    | R    |               |
|                         |   | T    | R    |               |
| 2. Property Controlling | S | T    | R    |               |
| in Section              | S | T    | R    |               |
| 3. Miscellaneous        | S | T    | R    |               |
| Property in Sec.        | S | T    | R    |               |
| 4. Lot No.              |   |      |      | Recorded Plat |
| 5. Private Claims       |   |      |      |               |

RECEIVED & FILED  
DIANE FRANKOVICH  
MACKINAC COUNTY REGISTER OF DEEDS

FEB 25 2000

AVA 2M  
3/19/00 11:12/11:21/11:31

Register of Deeds Stamp & File Number

	A	B	C	C	E	F	G	H	I	J	K	L	M
1													
2	6		5		4		3		2		1		
3													
4	7		8		9		10		11		12		
5													
6	18		17		16		15		14		13		
7													
8	19		20		21		22		23		24		
9													
10	30		29		28		27		26		25		
11													
12	31		32		33		34		35		36		
13													

I, Neil E. Hill, in a field survey on 12-20-99, do hereby state that under requirements of P.A. 74, Michigan P.A. of 1970, the corner points mentioned in lines 1 and 2 above were in conformance with regulations and rules therefore as required in the current manual of survey instructions of the United States Department of the Interior, Bureau of Land Management or by a decree of a Court of Law and /or that the corner points mentioned in lines 3, 4 and 5 above were in conformance with the rules of the Michigan Board of Land Surveyors or by a Decree of a Court of Law; established, re-established, monumented, recovered, found as expressed below:

NOTE: Not more than 2 corners, all in the same town and range, may be recorded on this certificate.

A. Description of original monument and accessories and/or subsequent restoration:

1845 GLO Notes J H Mullett	8" Beech	S 65 W	17 lks
	15" Beech	N 49 E	18 lks
1986 Neil E Hill	3" Apple	Due W	29.19'
Fd 1" Iron pin and	6" Maple	N 35 W	45.69'
MDOT witnesses	5" Ironwood	N 05 W	55.08'
Liber C Page 174	P Pole	S 85 E	38.69'

ACCEPTED BY THE MACKINAC COUNTY  
SURVEY PEER GROUP AS THE  
OFFICIAL CORNER UNDER P.A.  
345 OF 1990 AT A MEETING  
HELD ON 12-03-99

Neil E Hill

No Subsequent Information


B. Description of corner evidence found and/or method applied in restoring or reestablishing corner:

1999 1" Iron in gravel road  
Accepted corner location

C. Description of monument for corner and accessories established to perpetuate locating the position of the corner:

Corner is a 1" Iron pin  
Corner is 6' West of CL gravel road

5" Apple	Due W	29.13'
8" Maple	N 35 W	45.71'
P Pole	S 85 E	38.72'
5" W Birch	N 45 W	46.41'

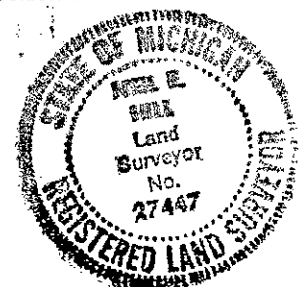

Bearings are compass bearings, corrected for declination, all distances are to a double-head nail in the side of the witness object unless otherwise noted.

January 21 2000

Signed by: Neil E Hill P.S.R.C.

Date

Surveyor's Michigan License No. 27447

F C0018