

LAND CORNER RECORDATION CERTIFICATE
Filing Requirement of Act 74, Mich. P.A. 1970

MAR 20 2000

Mackinac County Remonumentation Corner

SECTION

For corners in

Mackinac County Located in: Corner Code #

1. Public Land Survey T41N R04W K-12
T R
T R
T R

2. Property Controlling S T R
in Section S T R

3. Miscellaneous S T R
Property in Sec. S T R

4. Lot No. , Recorded Plat

5. Private Claims

RECEIVED & FILED
DIANE FRANKOVICH
MACKINAC COUNTY REGISTER OF DEEDS

FEB 25 2000

AM PM
7/9/9/10/11/12/13/14/15/16

Register of Deeds Stamp & File Number

	A	B	C	D	E	F	G	H	I	J	K	L	M
1													
2	6		5		4		3		2		1		
3													
4	7		8		9		10		11		12		
5													
6	18		17		16		15		14		13		
7													
8	19		20		21		22		23		24		
9													
10	30		29		28		27		26		25		
11													
12	31		32		33		34		35		36		
13													

I, Neil E. Hill, in a field survey on 12-20-99, do hereby state that under requirements of P.A. 74, Michigan P.A. of 1970, the corner points mentioned in lines 1 and 2 above were in conformance with regulations and rules therefore as required in the current manual of survey instructions of the United States Department of the Interior, Bureau of Land Management or by a decree of a Court of Law and /or that the corner points mentioned in lines 3, 4 and 5 above were in conformance with the rules of the Michigan Board of Land Surveyors or by a Decree of a Court of Law; established, re-established, monumented, recovered, found as expressed below:

NOTE: Not more than 2 corners, all in the same town and range, may be recorded on this certificate.

A. Description of original monument and accessories and/or subsequent restoration:


1845 GLO Notes J H Mullett	10" Aspen for 1/4 post		
1977 Lawrence Feindt (C A&E)	8" Birch	N 10 E	3.70'
Set T Iron w/ cap #	7" Cedar	S 30 E	10.85'
Liber 2 Page 343	9" Birch	Due W	9.00'
	11" Balsam	S 45 W	25.75'
1984 Harold Stockholm &	7" W Birch	N 08 E	3.33'
Gregory Asher	8" Cedar	S 63 E	10.70'
USDA Forrest Service Map #7	9" Balsam	S 35 W	25.43'
Fd iron and 4 witnesses	8" W Birch	S 84 W	8.93'

ACCEPTED BY THE MACKINAC COUNTY
SURVEY PEER GROUP AS THE
OFFICIAL CORNER UNDER P.A.
345 OF 1990 AT A MEETING
HELD ON 12-23-99
Neil E. Hill

No Subsequent Information

B. Description of corner evidence found and/or method applied in restoring or reestablishing corner:

1999 Fd T Iron and 2 witnesses
Accepted corner location
Placed 1/2 rod with 4" Alum remonumentation cap

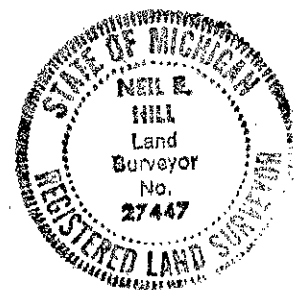

C. Description of monument for corner and accessories established to perpetuate locating the position of the corner:

Corner is a 1/2" rod with 4" Alum remonumentation cap

10" Cedar	S 30 E	10.89'
12" W Birch	Due W	9.25'
6" Cedar	N 50 E	10.96'
6" W Birch	S 10 W	27.13'

Bearings are compass bearings, corrected for declination, all distances are to a double- head nail in the side of the witness object unless otherwise noted.

Signed by: Neil E. Hill P.S., P.C.

Date: January 21 2000

Surveyor's Michigan License No. 27447