

SURVEY & REMONUMENTATION

MAR 13 1998

SECTION

1997 Mackinac County Remonumentation Corner
LAND CORNER RECORDATION CERTIFICATE
Filing Requirement of Act 74, Mich. P.A. 1970

For corners in

Mackinac
(County)

Located In:

Corner Code #

1. Public Land Survey

T 42NR 1W

M-9

T 42NR 1E

A-9 ✓

T R

T R

2. Property Controlling
in Section

S

T R

S

T R

3. Miscellaneous
Property in Sec.

S

T R

S

T R

4. Lot No. _____, Recorded Plat _____

5. Private Claims _____

I, David B. Guthrie, in a field survey on Dec. 17, 19 97 do hereby state that under requirements of P.A. 74, Michigan P.A. of 1970, the corner points mentioned in lines 1 and 2 above were in conformance with regulations and rules therefore as required in the current manual of survey instructions of the United States Department of the Interior, Bureau of Land Management or by a decree of a Court of Law and/or that the corner points mentioned in lines 3, 4 and 5 above were in conformance with the rules of the Michigan Board of Land Surveyors or by a Decree of a Court of Law; established, re-established, monumented, recovered, found as expressed below:

NOTE: Not more than 2 corners, all in the same town and range, may be recorded on this certificate.

RECEIVED & FILED
DIANE PRAPKOVICH
MACKINAC COUNTY REGISTER OF DEEDS

DEC 31 1997

AM PM
7(8)9(10)11(12)13(14)15(16)

Register of Deeds Stamp & File Number

	A	B	C	D	E	F	G	H	I	J	K	L	M
1													
2	6		5		4		3		2		1		
3													
4	7		8		9		10		11		12		
5													
6	18		17		16		15		14		13		
7													
8	19		20		21		22		23		24		
9													
10	30		29		28		27		26		25		
11													
12	31		32		33		34		35		36		
13													

A. Description of original monument and accessories and/or subsequent restoration:
1840: G.L.O. Survey by Wm. A. Burt - Set Post and Referenced

1973: Survey by Mary C. Pientdt - Found 1/2" Rod in Monument Box.

1984: Survey by Larry R. Rogers - Found iron pin in Monument Box.

1992: Survey by Neil E. Hill - Found boat spike in Monument Box.
Liber B Page 134

B. Description of corner evidence found and/or method applied in restoring or reestablishing corner:

1997: Remonumentation survey by R.S. Scott Associates, Inc.
Found 1/2" boat spike in Monument Box.

This corner position is compatible with County and local surveys. This corner position is accepted as a careful and faithful perpetuation of the position of the original corner.

ACCEPTED BY THE MACKINAC COUNTY
SURVEY PEER GROUP AS THE
OFFICIAL CORNER UNDER P.A.
345 OF 1990 AT A MEETING
HELD ON 12-19-97

C. Description of monument for corner and accessories established to perpetuate locating the position of the corner:


1997: Placed 3" Mackinac County Cap stamped to identify the corner over 1/2" Iron Rod set over 1/2" boat spike in Monument Box.

Referenced -

(Exist.) MDSH Tag - S60°E - 63.52' - 8" Cedar Post
S47°W - 83.30' - 12" Cedar

(Exist.) MDSH Tag - N69°W - 63.38' - P.P.

(Exist.) MDSH Tag - N82°E - 67.40' P.P.

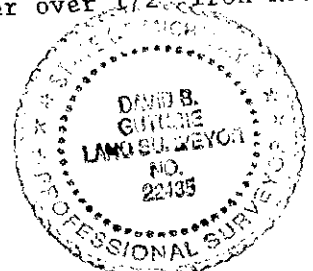

Signed by

D.B. Guthrie

Date

12-22-97

Surveyor's Michigan License No. 22435