JAN 21 1999

## LAND CORNER RECORDATION CERTIFICATE Filing Requirement of Act 74, Mich. P.A. 1970

SECTION

Mackinac County Remonumentation Corner

For comers in

Corner Code # Located in: Mackinac County 1. Public Land Survey T42N R01W F-5 Ţ R Т R R Т Т R S 2. Property Controlling R in Section S Т R 3. Miscellaneous S Ţ R Property in Sec. S

4. Lot No.

, Recorded Plat

5. Private Claims

I, Neil E Hill, in a field survey on 12-21-98, do hereby state that under requirements of P.A. 74, Michigan P.A. of 1970, the corner points mentioned in lines 1 and 2 above were in conformance with regulations and rules therefore as required in the current manual of survey instructions of the United States Department of the Interior, Bureau of Land Management or by a decree of a Court of Law and /or that the corner points mentioned in lines 3, 4 and 5 above were in conformance with the rules of the Michigan Board of Land Surveyors or by a Decree of a Court of Law; established, re-established, monumented, recovered, found as expressed below;

NOTE: Not more than 2 corners, all in the same town and range, may be recorded on this certificate.

A. Description of original monument and accessories and/or subsequent restoration:


| 1845 GLO Notes James Mullett  | 10" Beech  | S 72 W | 08 lks   |
|---|------------|--------|----------|
|   | 12' W Pine | S 66 E | 22 lks   |
| 1956 DNR Billy Buckler 3/4" Steel pin placed from Original evidence Liber 2, Page 315 | 6" S Maple | N 41 E | 12.5 lks |
|   | 6" Red Oak | S 19 W | 57 lks   |
| 1988 R Bischer  | 9" Maple   | N 39 E | 8.20 ft  |
| Fd ¾" Bar   | 11" Oak    | S 16 W | 37.87 ft |
| Liber C, Page 330   | 16" Beech  | S 76 W | 33.53 ft |

RECEIVED & FILED

DIANE FRANKOVICH

DEC 3 1 1998 7181911011111211213141516

Register of Deeds Stamp & File Number

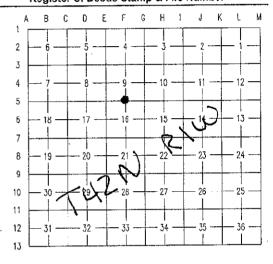


ACCEPTED BY THE MACKINAC COUNTY SURVEY PEER GROUP AS THE OFFICIAL CORNER UNDER PA. 345 OF 1990 AT A MEETING 12-04-08 NEX HELD ON

- B. Description of corner evidence found and/or method applied in restoring or reestablishing corner:
  - 1998 Fd 3/2" rebar and 2 DNR witnesses, and 1 Bischer witness Pulled and replaced corner with 5/8" rebar Accepted corner location

Corner is 5/8" rebar with 4" Alum, remonumentation cap

N 39 E 8.76 (Old) 9" Maple 33,60' S 76 W 16" Beech 42.85 6" Tri-Beech S 20 E 14.26' 8" Oak N 55 W

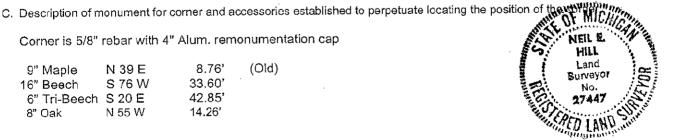

Bearings are compass bearings, corrected for declination, all distances are to a double-headed nail in the side of the witness object unless otherwise noted.

95. Signed by

12-29-98 Date

Surveyor's Michigan License No. 27447

FORM APPROVED BY M.CHIGAN STATE BOARD OF PROFESSIONAL SURVEYORS, JAN. 28, 1971
REVISED MAY 14, 1975
REVISED JAN., 1983
REVISED OCT., 1995