

LAND CORNER RECORDATION CERTIFICATE  
Filing Requirement of Act 74, Mich. P.A. 1970

For corners in

Mackinac

(County)

Located In:

Corner Code #

1. Public Land Survey

T 42N R 12W

C11

T 42N R 12W

E9

T R

T R

2. Property Controlling  
in Section

S

T R

S

T R

3. Miscellaneous  
Property in Sec.

S

T R

S

T R

Register of Deeds Stamp & File Number

4. Lot No. \_\_\_\_\_, Recorded Plat \_\_\_\_\_

5. Private Claims \_\_\_\_\_

Apr 30 2002

I, Stephan J. Szyszkoski, in a field survey on \_\_\_\_\_, 20\_\_\_\_ do hereby state that under requirements of P.A. 74, Michigan P.A. of 1970, the corner points mentioned in lines 1 and 2 above were in conformance with regulations and rules therefore as required in the current manual of survey instructions of the United States Department of the Interior, Bureau of Land Management or by a decree of a Court of Law and/or that the corner points mentioned in lines 3, 4 and 5 above were in conformance with the rules of the Michigan Board of Land Surveyors or by a Decree of a Court of Law; established, re-established, monumented, recovered, found as expressed below:

NOTE: Not more than 2 corners, all in the same town and range, may be recorded on this certificate.

	A	B	C	D	E	F	G	H	I	J	K	L	M
1													
2		6		5		4		3		2		1	
3													
4		7		8		9		10		11		12	
5													
6		18		17		16		15		14		13	
7													
8		19		20		21		22		23		24	
9													
10		30		29		28		27		26		25	
11													
12		31		32		33		34		35		36	
13													

A. Description of original monument and accessories and/or subsequent restoration:

(C11) Corner common to Sections 29-30-31-32. 1959: Record of Billy D. Buckler RLS: Replaced cor. from one Cedar B.T. (green) in excellent condition. Tree bearing SE from Cor. Cor. found by District Survey Crew. 1" pipe with 4" brass cap. 8" Cedar S39E 21.5 links, 9" Cedar N60W 12 links, 10" Cedar N69E 29.5 links.

(E9) Corner common to Sections 20-21-28-29. 1959: Record of Billy D. Buckler RLS: Replaced cor. from one Cedar stp. (probable B.T.) bearing S83W 17 links. Found rotted face and overgrowth on stp. Position fits well with swamp edges. Cor. placed and wit. 6/5/59 with B. McDonald, Aide. 1" pipe with 4" brass cap. 4" cedar N75E 33 links, 4" cedar N21W 25 links, 6" aspen S07E 22 links.

B. Description of corner evidence found and/or method applied in restoring or reestablishing corner.

(C11) Recovered the 1959 monument in good condition and at record bearing and distance from the stump remains of all three 1959 witnesses. Scribing is visible only on the NE NBT. The original BT Cedar 9 S82E 20 links, now a 3' high rotted stump, was also found at record bearing and distance. Accepted the monument as a careful and faithful perpetuation of the position of the original corner. Left the monument in place and made new witnesses as described below.

(E9) Recovered the 1959 monument in good condition and at record bearing and distance from the stump remains of the 1959 NBTs. The NBT noted in the record has rotted away. Accepted the monument as the best available evidence of the position of the original corner. The area has been clearcut.

C. Description of monument for corner and accessories established to perpetuate locating the position of the corner.

(C11) Found 1" ID I.pipe with 4" brass cap. Blazed, scribed, and set measuring nails in:

5" W.Birch S60E 15.25' "S32 NBT"

5" W.Birch N60E 46.5' "S29 NBT"

4" W.Birch S88W 19.1' "S31 NBT"

4" W.Birch S07W 14.15' do

Old squared and scribed cedar post adjacent. Bearings are magnetic.

Distances are to nail with tag.

(E9) Found 1" ID I.pipe with 4" brass cap. Blazed, scribed, and set measuring nails in:


4" Cedar S16E 23.55' "S28 NBT"

3" Aspen N48W 2.95' "S20 NBT"

Set cedar post South 2.0'

Set cedar post West 2.0'

Bearings are magnetic. Distances are to nail with tag.

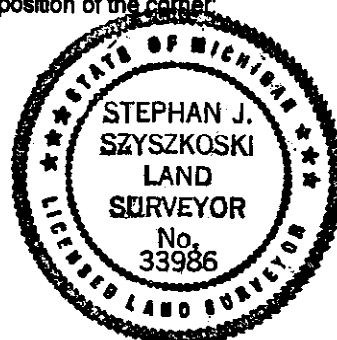

Signed by

Stephan J. Szyszkoski

Date

8/13/02

Surveyor's Michigan License No.

33986

For the Michigan Department of Natural Resources - Office of Property Management

FORM APPROVED BY MICHIGAN STATE BOARD OF PROFESSIONAL SURVEYORS, JAN. 28, 1971

REVISED MAY 14, 1975

REVISED JAN. 1983

REVISED OCT. 1985