

LAND CORNER RECORDATION CERTIFICATE
Filing Requirement of Act 74, Mich. P.A. 1970 as Amended

For corners in

Mackinac Located In: Corner Code #
1. Public Land Survey
2. Property Controlling in Section
3. Miscellaneous Property in Sec.
4. Lot No. Recorded Plat
5. Private Claims

Register of Deeds Stamp & File Number

Table with 13 rows and 13 columns (A-M) for Register of Deeds Stamp & File Number.


I, Stephan J. Szyszkoski, in a field survey on 09/24/14 do hereby state that under requirements of P.A. 74, Michigan P.A. of 1970, the corner points mentioned in lines 1 and 2 above were in conformance with regulations and rules therefore as required in the current manual of survey instructions of the United States Department of the Interior, Bureau of Land Management or by a decree of a Court of Law and /or that the corner points mentioned in lines 3, 4 and 5 above were in conformance with the rules of the Michigan Board of Land Surveyors or by a Decree of a Court of Law; established, re-established, monumented, recovered, found as expressed below:

NOTE: Not more than 2 corners, all in the same town and range, may be recorded on this certificate.

A. Description of original monument and accessories and/or subsequent restoration:

(1-Sec. 19) West 1/16 corner between Sections 18 and 19. Not previously monumented.

(4-Sec. 19) Northwest 1/16 corner, Section 19. Not previously monumented.

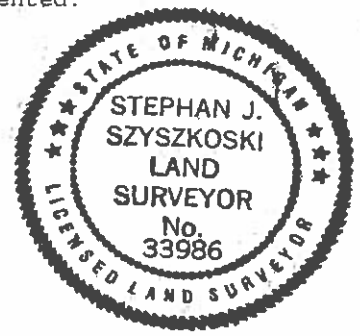

B. Description of corner evidence found and/or method applied in restoring or reestablishing corner:

(1-Sec. 19) Established the position for the corner on the Section line between Section corner 1322.51' west and Quarter corner 1327.15' east, being 20 chains, proportionate to the original record, west of Quarter corner B7.

(4-Sec. 19) Established the position for the corner at the intersection of straight lines connecting opposite 1/16 corners. 1/16 corner #8, to the south, is 1326.75' west of the intersection of 1/4 lines of Section 19, being 20 chains, proportionate to the original record, west of said intersection.

C. Description of monument for corner and accessories established to perpetuate locating the position of the corner:

- (1) Set 1"IDx28" I.pipe with 2" alum. MDNR cap. Set measuring nail with MDNR tag in the side of: 12" Cedar S45°E 45.15' mrkd "W1/16 BT" 9" Balsam S33°W 9.28' do 16" Cedar N48°W 25.89' do 13" Cedar N19°W 22.36' do E= 8194526.092 N= 151107.446
- (4) Set 1"IDx28" I.pipe with 2" alum. MDNR cap. 10" B.Spruce N06°W 4.46' mrkd "NW1/16 BT" 8" Balsam S46°W 37.60' do 14" Cedar S11°E 45.22' do 16" Cedar S48°E 34.45' do E= 8194538.440 N= 150707.202

Bearings are magnetic. Coordinates are MCS83 in meters (NAD83(2011) Datum). Coord. Ref.=NGS PID DK4187: N= 145817.497 m. E= 8204066.245 m.

Signed by [Signature] Date 01/28/2015
Surveyor's Michigan License No. 33986

For the Michigan Department of Natural Resources, Forest Resources Division