

MICHIGAN
DEPARTMENT OF CONSERVATION
FORESTRY DIVISION

LAND CORNER RECORD

T. 43 N. R. 8W


Mackinac COUNTY

DESCRIPTION OF CORNER Sec. Corner common to Secs. 7-8-17-18

CORNER MONUMENT 1" Pipe with 4" Aluminum Cap

DATE MONUMENT PLACED AND WITNESSED 6-28-68

WITNESSES TO CORNER..... 7" B.Spruce (S7 NBT) N1⁰W 15.0'

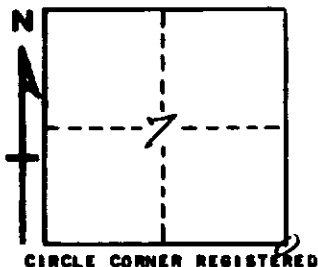

7" B.Spruce (S17 NBT) S82⁰E 18.8'

AND

DESCRIPTION IN DETAIL AS TO HOW CORNER WAS LOCATED AND IDENTIFIED OR RESTORED.

This corner placed by proportionate measure from corners to east and west
and from swamp edges to north and south.
Found a white post set by Kimberly-Clark Corp, lying 93.1' east of corner.

SURVEYOR'S SEAL

Billy D. Buckler
SIGNED Billy D. Buckler, R.L.S. DATE 10-8-68
REGISTERED LAND SURVEYOR