

MICHIGAN  
DEPARTMENT OF CONSERVATION  
FORESTRY DIVISION

LAND CORNER RECORD

T. 43N N.R. 8W


Mackinac COUNTY

DESCRIPTION OF CORNER Sec. Cor. common to Secs. 11-12-13-14

CORNER MONUMENT 1" pipe with 4" aluminum cap

DATE MONUMENT PLACED AND WITNESSED 4-29-68

WITNESSES TO CORNER..... 7" cedar (S12 NBT) N16°E 12.4°

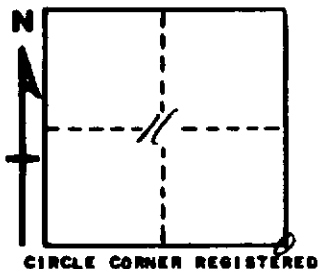

7" cedar (S13 NBT) S87°E 13.7°

AND

DESCRIPTION IN DETAIL AS TO HOW CORNER WAS LOCATED AND IDENTIFIED OR RESTORED.

This corner placed at record distance; 40 links east and 40 links south of a small stream.

Corner lies in a cedar swamp, 100' north of an old camp bottom.

Record notes indicate hardwood witnesses, being 1½ chs south of the cedar swamp. Believe they are erroneous. Corner is in cedar swamp, 1½ chs. south of the north edge.

Find numerous stream crossings to south <sup>which</sup> original notes do not mention.

SURVEYOR'S SEAL

SIGNED Billy D. Buckler  
Billy D. Buckler, R.L.S., DATE 9-20-68  
REGISTERED LAND SURVEYOR