

LAND CORNER RECORDATION CERTIFICATE
Filing Requirement of Act 74, Mich. P.A. 1970

For corners in
Mackinac

(County)

Located In:

Corner Code #

1. Public Land Survey

T 44N R 7W E6
T R
T R
T R
T R

2. Property Controlling
in Section

S T R
S T R
S T R
S T R

3. Miscellaneous
Property in Sec.

S T R
S T R
S T R
S T R

Register of Deeds Stamp & File Number

4. Lot No. , Recorded Plat
5. Private Claims

May 30 2002

I, Stephan J. Szyszkoski, in a field survey on _____, 19____ do hereby state that under requirements of P.A. 74, Michigan P.A. of 1970, the corner points mentioned in lines 1 and 2 above were in conformance with regulations and rules therefore as required in the current manual of survey instructions of the United States Department of the Interior, Bureau of Land Management or by a decree of a Court of Law and /or that the corner points mentioned in lines 3, 4 and 5 above were in conformance with the rules of the Michigan Board of Land Surveyors or by a Decree of a Court of Law; established, re-established, monumented, recovered, found as expressed below:

NOTE: Not more than 2 corners, all in the same town and range, may be recorded on this certificate.

	A	B	C	D	E	F	G	H	I	J	K	L	M
1													
2	6			5		4		3		2		1	
3													
4	7			8		9		10		11		12	
5													
6	18			17		16		15		14		13	
7													
8	19			20		21		22		23		24	
9													
10	30			29		28		27		26		25	
11													
12	31			32		33		34		35		36	
13													

A. Description of original monument and accessories and/or subsequent restoration:


(E6) Quarter corner common to Sections 16-17. 1960: Record of Billy D. Buckler, RLS states: "This corner was reestablished midway and on line between two Section Corners. Found no evidence of original corner. 1" pipe with 4" brass cap. 16" Y.Birch West 14 links, 9" Cedar S35E 59 links".

B. Description of corner evidence found and/or method applied in restoring or reestablishing corner:

(E6) The original post and accessories were not recovered. Found the 1960 monument in good condition and at record bearing and distance from the 1960 witnesses. I did not accept the position of the 1960 monument as a proper reestablishment of the position of the original corner. It appears that the 1960 monument was erroneously placed about 66 feet south and 4 feet west of the position intended in 1960. Removed the 1960 monument and placed it midway and on a straight line between Section Corners 2652.28 feet north and south. Defaced the 1960 witness trees.

C. Description of monument for corner and accessories established to perpetuate locating the position of the corner:

(E6) Set 1"IDx36" I.pipe with 4" brass
MI Dept. of Conservation cap. Blazed,
scribed, and set measuring nails in:
10" Y.Birch S33W 2.3' "1/4S N8T"
8" Spruce S29E 5.9' do
8" Maple S88E 21.15' do
8" Maple N13W 10.65' do
Bearings are magnetic. Distances are to
nail with tag.

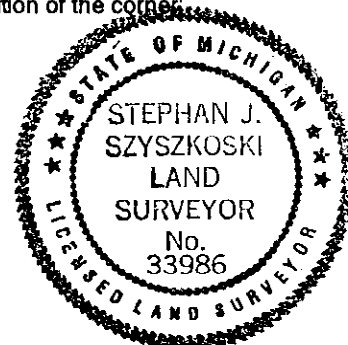

Signed by Stephan J. Szyszkoski
Surveyor's Michigan License No. 33986

Date 8/6/02

For the Michigan Department of Natural Resources - Office of Property Management

FORM APPROVED BY MICHIGAN STATE BOARD OF PROFESSIONAL SURVEYORS, JAN. 28, 1971
REVISED MAY 14, 1975
REVISED JAN., 1983
REVISED OCT., 1985