


SURVEY &
REMONUMENTATION

NOV 06 1998

SECTION

Sterling Township T2N, R12E

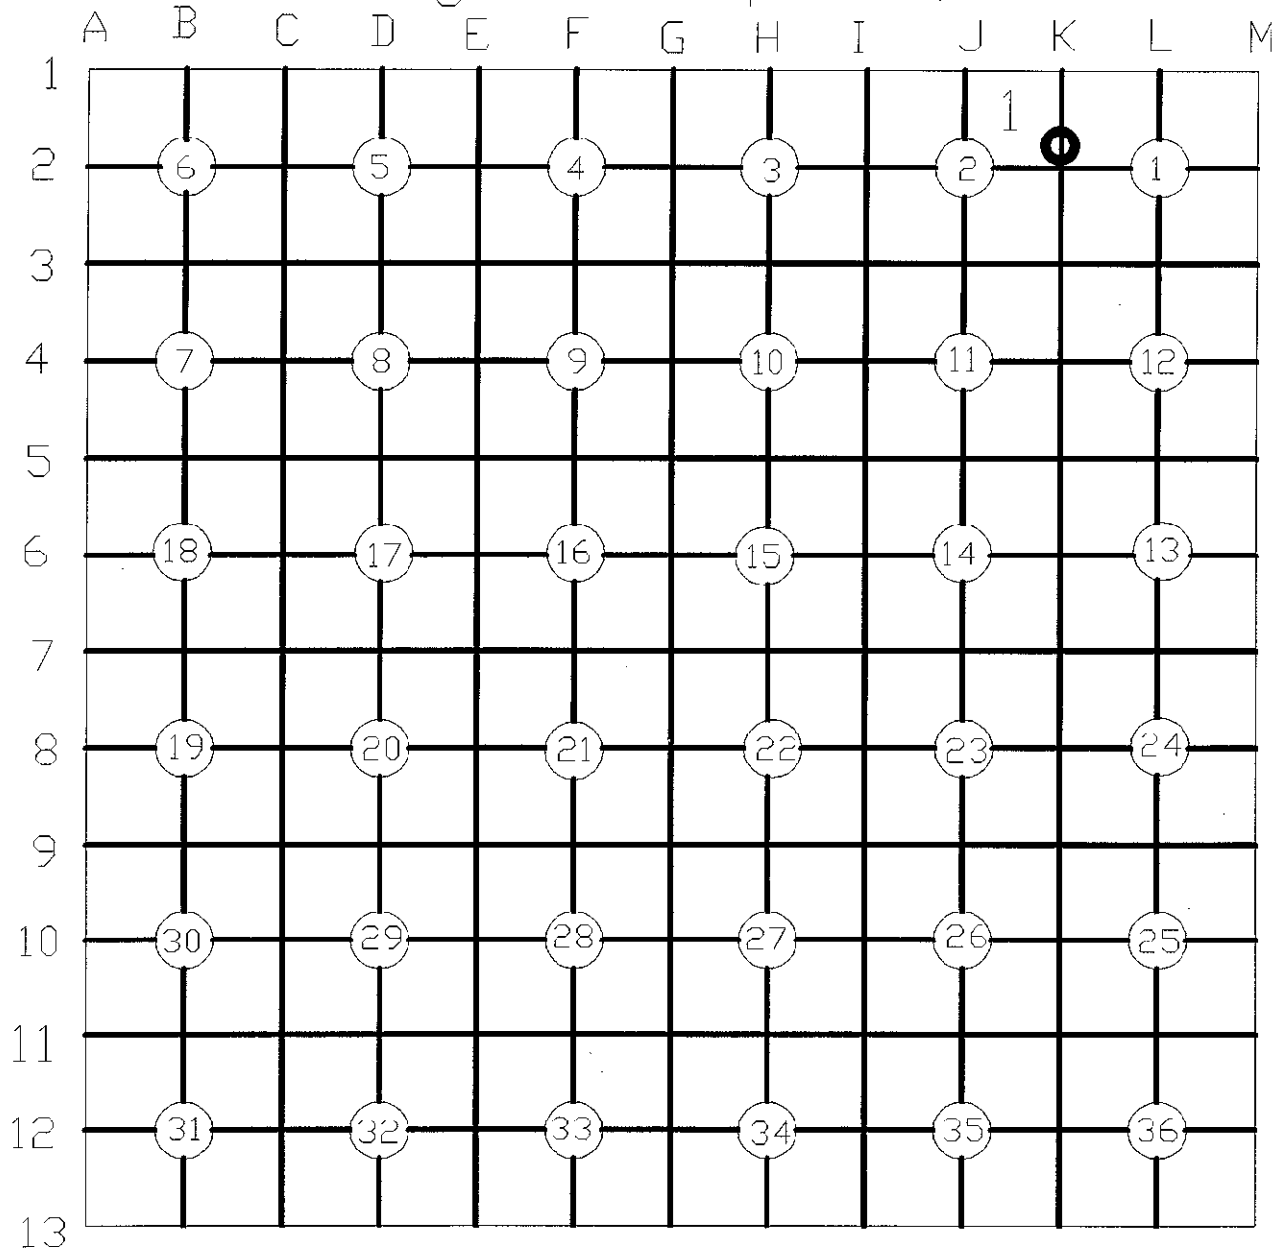

1 = PPC NORTH OF K-2

RECORDED L 6151 P 220 #803