

LAND CORNER RECORDATION CERTIFICATE
Filing Requirement of Act 74, Mich. P.A. 1970

For corners in

Macomb
(County)

Located In: Washington Township Corner Code #

SURVEY &
REMONUMENTATION

OCT 19 1998

SECTION

1. Public Land Survey

T 4N R 12E A-11
T R
T R
T R
S T R
S T R
S T R
S T R

2. Property Controlling
in Section

3. Miscellaneous
Property in Sec.

4. Lot No. _____ Recorded Plat _____
5. Private Claims _____

Register of Deeds Stamp & File Number

I, Huston K. Kennedy, in a field survey on April 24, 1998 do hereby state that under requirements of P.A. 74, Michigan P.A. of 1970, the corner points mentioned in lines 1 and 2 above were in conformance with regulations and rules therefore as required in the current manual of survey instructions of the United States Department of the Interior, Bureau of Land Management or by a decree of a Court of Law and/or that the corner points mentioned in lines 3, 4 and 5 above were in conformance with the rules of the Michigan Board of Land Surveyors or by a Decree of a Court of Law; established, re-established, monumented, recovered, found as expressed below:

NOTE: Not more than 2 corners, all in the same town and range, may be recorded on this certificate.

	A	B	C	D	E	F	G	H	I	J	K	L	M
1													
2	6		5		4		3		2		1		
3													
4	7		8		9		10		11		12		
5													
6	18		17		16		15		14		13		
7													
8	19		20		21		22		23		24		
9													
10	30		29		28		27		26		25		
11													
12	31		32		33		34		35		36		
13													

A. Description of original monument and accessories and/or subsequent restoration:
1817-GLO Wampler, D.S.; Set Post 30" Black Oak N14°E 38 Links; 40" Black Oak S61°W 48 Links

B. Description of corner evidence found and/or method applied in restoring or reestablishing corner:
1998-Kennedy Surveying, Inc. - Kennedy, PS #17623 - The corner was recovered by using GLO Notes. The stagger between the M-11 & A-11, per the GLO Notes, is 12 Links or 7.92 feet. The corner as recovered is on a straight line between M-11 to M-10, 7.92 feet North of M-11 and is located at the Southeast corner of an island in Stoney Creek Metropark. I found a 4" diameter Concrete Monument with a 2" diameter brass cap stamped Oakland County Remonumentation PS #22445 that is 7.92 feet to the South, which is being used and accepted as a common corner for Sections 25 & 36, T4N, R11E, Oakland Township (M-11).

FIELD MEASUREMENTS BETWEEN

A-11 to A-10
No GLO
2625.19 Ft. (GPS-GROUND)

A-11 to B-11 (B-11 has not yet been reviewed or approved by the peer group)
GLO = 40.54 chains or 2675.64 Ft.

ACCEPTED BY THE MACOMB COUNTY SURVEY PEER
GROUP AS THE OFFICIAL CORNER UNDER MICHIGAN
PUBLIC ACT 345 OF 1990 AT A MEETING HELD
ON 6/30/98
William E. Soerberg
WILLIAM E. SOERBERG, P.S., CHAIRMAN

A-11 to A-12
No GLO
2649.94 Ft. (GPS-GROUND)

A-11 to M-11
GLO = 12 links or 7.92 Ft.
7.92 Ft. (GPS-GROUND)

C. Description of monument for corner and accessories established to perpetuate locating the position of the corner:
A-11 I set a 4" diameter Concrete Monument with 1/2" Iron Rod w/2" diameter aluminum cap stamped "Macomb County Monument, MI Act #345" #17623
Due South 13.11' Fnd PK Nail w/ Washer stamped Oakland County Remon. PS #22445 West face 8" Bass Wood
N07°W 28.72' Fnd PK Nail w/Washer stamped Oakland County Remon. PS #22445 SW face 21" Oak
S67°E 28.09' Fnd PK Nail w/Washer stamped Oakland County Remon. PS #22445 North face 10" Wain
S34°W 16.30' Fnd PK Nail w/Washer stamped Oakland County Remon. PS #22445 NW face 16" Oak
South 7.92 feet, corner common to Sections 25 & 36, T4N, R11E, Oakland Twp., (M-11)

The selected location is accepted by me and is generally accepted by Professional Surveyors as the best available evidence of the position of the original corner.

Signed by: [Signature]
Surveyor's Michigan License No. 17623

Date 7-2-98




FORM APPROVED BY MICHIGAN STATE BOARD OF PROFESSIONAL SURVEYORS, JAN. 28, 1971
REVISED MAY 14, 1971
REVISED JAN., 1981
REVISED OCT., 1991

for the general public throughout the year at the various Metroparks, nature interpretive areas, farm center and historical grist mill.
For current information about these formal programs and other park activities, pick up a free copy of the "METROPARKS NEWS," the Metroparks' quarterly newsletter, at any of the Metroparks or the Administrative Offices. To have a newsletter mailed to you free of charge, simply send your name and address to: MCMA Newsletter, P.O. Box 2001, Brighton, Michigan 48116-8001.

STONY CREEK METROPARK

4300 MAIN PARK RD., SHELBY TWP., MICHIGAN 48316 TELEPHONE: 781-4242
OUTSIDE LOCAL DIALING AREA: 1-800-47-PARKS

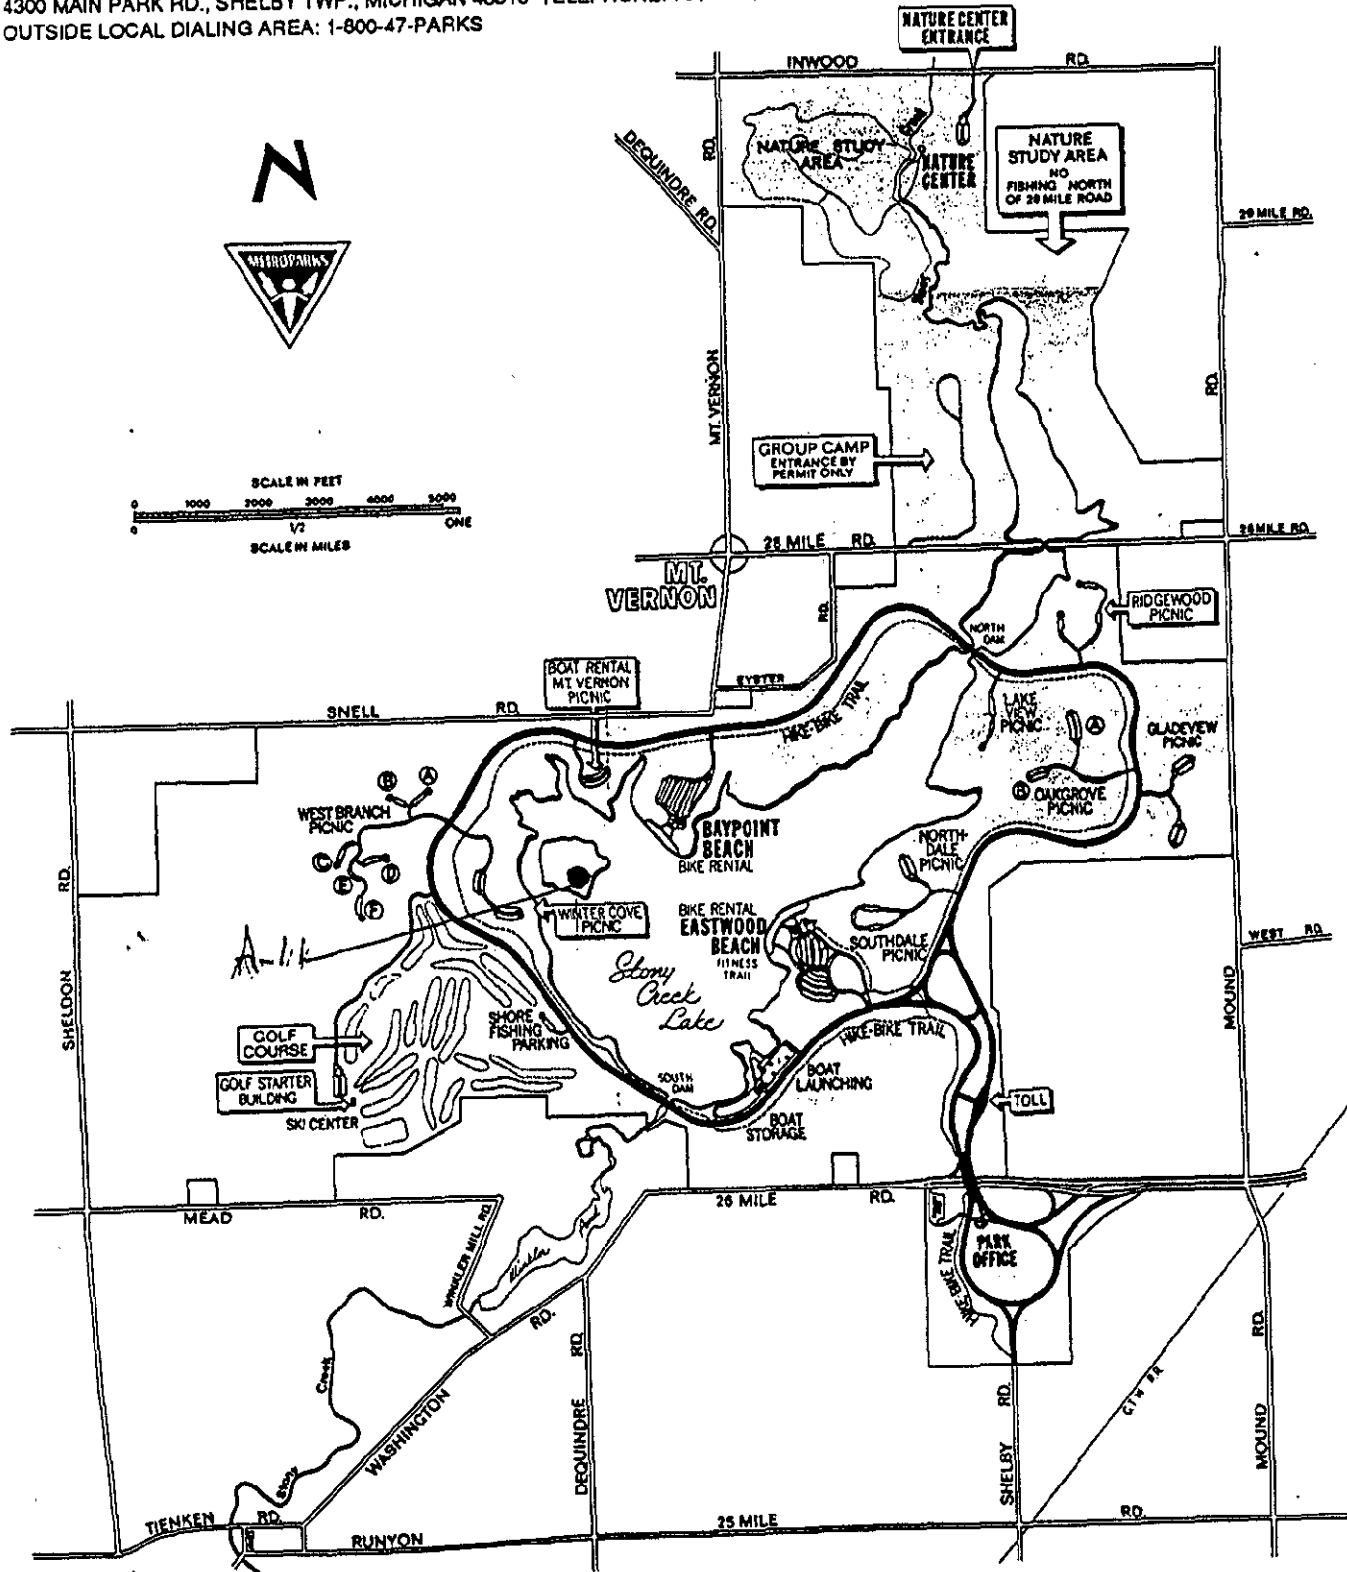

C0739160 LIBER:08159 PAGE:452 09:54A 07/21/1998
CARMELLA SABAUGH-MACOMB COUNTY, MI REG/DEEDS

SECTION

OCT 19 1998

SURVEY &
RECONUMENTATION