

**LAND CORNER RECORDATION CERTIFICATE**  
 Filing Requirement of Act 74, Mich. P.A. 1970

For corners in

MACOMB  
 (County)

RAY TOWNSHIP  
 Located In: Corner Code #

- |                                    |                            |            |
|------------------------------------|----------------------------|------------|
| 1. Public Land Survey              | T <u>4</u> N R <u>13</u> E | <u>M-8</u> |
|                                    | T ___ R ___                | _____      |
|                                    | T ___ R ___                | _____      |
|                                    | T ___ R ___                | _____      |
| 2. Property Controlling in Section | S ___ T ___ R ___          | _____      |
|                                    | S ___ T ___ R ___          | _____      |
| 3. Miscellaneous Property in Sec.  | S ___ T ___ R ___          | _____      |
|                                    | S ___ T ___ R ___          | _____      |

SURVEY &  
 REMONUMENTATION

MAP 15 1999

SECTION

Register of Deeds Stamp & File Number

4. Lot No. \_\_\_\_\_, Recorded Plat \_\_\_\_\_  
 5. Private Claims \_\_\_\_\_

I, ROBERT H. BIRKETT, in a field survey on JULY 22, 1997 do hereby certify that under requirements of P.A. 74, Michigan P.A. of 1970, the corner points mentioned in lines 1 and 2 above were in conformance with regulations and rules therefore as required in the current manual of survey instructions of the United States Department of the Interior, Bureau of Land Management or by a decree of a Court of Law and for that the corner points mentioned in lines 3, 4 and 5 above were in conformance with the rules of the Michigan Board of Land Surveyors or by a Decree of a Court of Law, established, re-established, monumented, re-monumented, recovered, found as expressed below.

NOTE: Not more than 2 corners, all in the same town and range, may be recorded on this certificate.

	A	B	C	D	E	F	G	H	I	J	K	L	M
1													
2	6	5	4	3	2	1							
3													
4	7	8	9	10	11	12							
5													
6	18	17	16	15	14	13							
7													
8	19	20	21	22	23	24							
9													
10	30	29	28	27	26	25							
11													
12	31	32	33	34	35	36							
13													

A. Description of original monument and accessories and/or subsequent restoration:

- M-8 1817, W. PRESTON, D. S., SET CEDAR POST, G. L. O..  
 1) 1989, J. BAILEY #33968, FOUND P. K. NAIL, UNRECORDED SURVEY.  
 2) 1996, J. BAILEY #33968, FOUND P. K. NAIL, UNRECORDED SURVEY.

B. Description of corner evidence found and/or method applied in restoring or reestablishing corner:

- M-8 FOUND P. K. NAIL CENTERLINE OF ASPHALT NEW HAVEN ROAD  
 (1,2) S.E. - 128.12' - NAIL IN P.P.  
 (1,2) SOUTH - 36.15' - IRON #14097  
 (1,2) WEST - 55.24' - NAIL IN P.P.  
 (1,2) NORTH 36.76' - IRON #15405

ACCEPTED BY THE MACOMB COUNTY SURVEY PEER GROUP AS THE OFFICIAL CORNER UNDER MICHIGAN PUBLIC ACT 345 OF 1980 AT A MEETING HELD ON 10/27/98

*William E. Soderberg*  
 WILLIAM E. SODERBERG, P.S., CHAIRMAN

**FIELD MEASUREMENTS**

- M-8 TO M-7, GLO (1817) - 40 CHAINS (2640')  
 NO PREVIOUS RECORDED DISTANCE.  
 RE-MONUMENTATION (1997) - 2701.78'


- M-8 TO M-9, GLO (1817) - 40 CHAINS (2640')  
 NO PREVIOUS RECORDED DISTANCE.  
 RE-MONUMENTATION (1997) - 2673.32'

C. Description of monument for corner and accessories established to perpetuate locating the position of the corner:  
 M-8 SET AN 3/4" IRON IN NEW MONUMENT BOX WITH A 2" DIAMETER ALUMINUM CAP STAMPED "MACOMB COUNTY MONUMENT, M ACT 345, #41094, M-8".

- AZ. 0° - 36.75' - FOUND 1/2" IRON W/CAO No. 15405.  
 AZ. 0° - 31.05' - A-8, TOWN 4 NORTH, RANGE 14 EAST, LENOX TOWNSHIP, MACOMB COUNTY.  
 AZ. 135° - 128.13' - SET MACOMB RE-MON TAG ABOVE FORM NAIL IN NORTH FACE UTILITY POLE  
 AZ. 180° - 36.18' - FOUND 1/2" IRON W/CAP No. 14097.  
 AZ. 270° - 55.26' - FOUND FORM NAIL IN NORTH FACE UTILITY POLE.

THE SELECTED LOCATION IS ACCEPTED BY ME AND IS GENERALLY ACCEPTED BY PROFESSIONALS AS THE BEST AVAILABLE EVIDENCE OF THE POSITION OF THE ORIGINAL CORNER.

Signed by *Robert H. Birkett* Date 12-30-98  
 Surveyor's Michigan License No. 41094

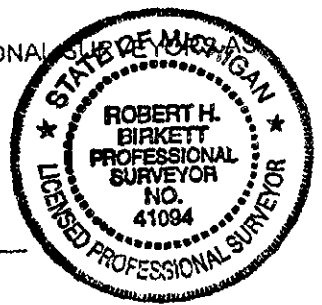

834