

OCT 31 1994

COMMISSION

LAND CORNER RECORDATION CERTIFICATE  
Filing Requirement of Act 74, Mich. P.A. 1970

For corners in

Manistee

(County)

Located In:

Corner Code #

1. Public Land Survey

T 21N R 15W

G - 3

T R

T R

T R

2. Property Controlling  
in Section

S T R

S T R

3. Miscellaneous  
Property in Sec.

S T R

S T R

4. Lot No. Recorded Plat

5. Private Claims

REGISTER'S OFFICE  
MANISTEE COUNTY

#94-372 AT 2:50 p.m.

AUG 16 1994

*Benny A. Pappas*  
REGISTER OF DEEDS

Register of Deeds Stamp & File Number

I, Kenneth L. Ross, in a field survey on July, 19 94

do hereby certify that under requirements of P.A. 74, Michigan P.A. of 1970, the corner points mentioned in lines 1 and 2 above were in conformance with regulations and rules therefore as required in the current manual of survey instructions of the United States Department of the Interior, Bureau of Land Management or by a decree of a Court of Law and/or that the corner points mentioned in lines 3, 4 and 5 above were in conformance with the rules of the Michigan Board of Land Surveyors or by a Decree of a Court of Law; established, re-established, monumented, re-monumented, recovered, found as expressed below:

NOTE: Not more than 4 corners, all in the same town and range, may be recorded on this certificate.

A. Description of original monument and accessories and/or subsequent restoration:

G-3 Section corner common to sections 3,4,9 & 10, T21N, R15W

1837, John Brink D.S., G.L.O. page 41

set wood post

1. Maple 12" S22E 39 lks

2. Maple 10" N50E 78 lks

May 23, 1907 E.W. Muenschler had corner

he dose not say what he found or set.

Book A Pages 39 & 40

Manistee County Road commission no date

Railroad spike

3. Corner fence post SW 47.55 ft.

4. Telephone pole SE 46.52 ft.

5. Fence post (4th) ENE 64.34 ft.

1992 Ken Ross found 1 1/2" pipe  
(under item B below)

B. Description of corner evidence found and/or method applied in restoring or reestablishing corner:

G-3 Section corner common to sections 3,4,9 & 10

T21N, R15W

On 7/21/94, found 1 3/4 OD pipe at intersection of

Kettle Hole & Pine Creek roads, condition of

record witnesses are: 1.gone 2. gone 3. found laying down

4. found in good condition 5. gone 6. same as 4

7. found in good condition 8. found in good condition

6. Power pole S42E 46.30 ft.

7. Power pole N68W 123.93 ft.

8. Post N40E 88.17 ft.

Corner G - 3 ratified by the Manistee County Peer Group  
according to the county plan adopted pursuant to P.A. 345 of 1990,  
as amended, (being the State Survey and Remonument Act, MCL 54.261  
et. seq.). Date of Peer Review: Benny A. Pappas  
ACTING CHAIRMAN

APPROVED AUG 1 1994

C. Description of monument for corner and accessories established to perpetuate locating the position of the corner:

G-3 Section corner common to sections 3,4,9 & 10 T21N, R15W


Replaced pipe with Manistee County monument (2 1/2" x30" steel pipe with a  
brass cap), placed in a monument box, and is accepted as a careful and  
faithful reestablishment of the position of the original corner.

(OBT 6) Powerpole stub S42E 46.30 ft (16d nail in center of top

(OBT 7) Powerpole N68W 123.93 ft (added 60d nail in NW side)

(OBT 8) Post N34E 88.12 ft. (added 60d nail in NW side)

White Pine 7" S79W 168.47 ft. (60d nail in NW side)

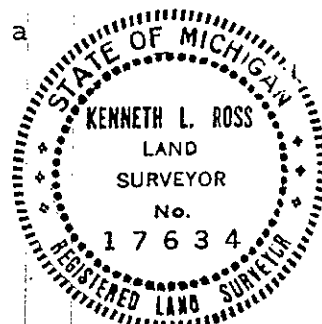

Signed by

*Kenneth L. Ross*

Date Aug. 1, 1994

Surveyor's Michigan License No.

17634