

SURVEY &  
REMONUMENTATION

DEC 09 1999

LAND CORNER RECORDATION CERTIFICATE

Filing Requirement of Act 74, Mich. P.A. 1970

For corners in SECTION

MANISTEE

(County)

Located In:

Corner Code #

1. Public Land Survey

T 21N R 16W

D-13 mc

T R

witness corner

T R

# 010

T R

2. Property Controlling  
in Section

S T 21N R 16W

S T R

3. Miscellaneous

S T R

Property in Sec.

S T R

4. Lot No. \_\_\_\_\_, Recorded Plat \_\_\_\_\_

5. Private Claims \_\_\_\_\_

REGISTER'S OFFICE  
MANISTEE COUNTY

99-174 at 4:15 pm

MAY 20 1999

Deborah Six

REGISTER OF DEEDS

Register of Deeds Stamp & File Number

I, Richard L. Hays, in a field survey on April 29 19 99, do hereby certify that under requirements of P.A. 74, Michigan P.A. of 1970, the corner points mentioned in lines 1 and 2 above were in conformance with regulations and rules therefore as required in the current manual of survey instructions of the United States Department of the Interior, Bureau of Land Management or by a decree of a Court of Law and/or that the corner points mentioned in lines 3, 4 and 5 above were in conformance with the rules of the Michigan Board of Land Surveyors or by a Decree of a Court of Law; established, re-established, monumented, re-monumented, recovered, found as expressed below:

NOTE: Not more than 4 corners, all in the same town and range, may be recorded on this certificate.

A. Description of original monument and accessories and/or subsequent restoration:

D-13 mc Witness to the meander corner on the East Shore of Shingle Mill Lake,  
Section 32, T21N-R16W.

1839, John Brink, G.L.O. Boundary Survey

Set Wood post at 40 chs.

#1 Maple 10" S 15 E 11 lks. (7.26')

#2 Maple 8" N 44 E 20 lks. (13.20')

1982, Robert A. Griffin, RLS #13584

Set 2" x 60" Iron pipe with a brass cap, as a witness to the meander corner.

#3 Black Oak 12" N 12 E 22.62'

#4 Red Pine 8" N 70 E 37.76'

B. Description of corner evidence found and/or method applied in restoring or reestablishing corner:

D-13 mc Witness to the meander corner on the East Shore of Shingle Mill Lake,  
Section 32, T21N-R16W.

On April 29, 1999, Kevin Pritchard (survey tech) and I found a 2" Iron Pipe with Brass Cap, 34 feet East of the shore-line, stamped w.c. (witness corner) with an arrow to the West, with a distance of 576.44' to C-13 mc, meander corner on the West Shore of Shingle Mill Lake. I found no evidence of the original meander corner.

CONDITION OF RECORD WITNESSES ARE AS FOLLOWS: #1 Gone #2 Gone #3 Found in good condition  
#4 Found in good condition

C. Description of monument for corner and accessories established to perpetuate locating the position of the corner:

D-13 mc Witness to the meander corner on the East Shore of Shingle Mill Lake,  
Section 32, T21N-R16W.

I accepted Robert Griffin's 2" x 60" Iron Pipe with brass cap, as a substantial marker for the witness corner to the meander corner, and is accepted as a careful and faithful re-establishment of the position of the original corner, I took two new witnesses.

OBT #3 Black Oak 15" N 12 E 22.80' (set 60d spike in west side of tree)

OBT #4 Red Pine 12" N 72 E 37.75' (found dock spike in NW side of tree)

Red Oak twin 17"-19" S 13 E 15.29 (set 60d spike in SW side of tree)

Red Oak 18" S 55 E 38.42' (set 60d spike in NE side of tree)

Signed by

Richard Hays

Date

5/19/99


Surveyor's Michigan License No.

25847

FORM APPROVED BY MICHIGAN STATE BOARD OF LAND SURVEYORS, JAN. 28, 1971  
REVISED MAY 14,

1975

1993

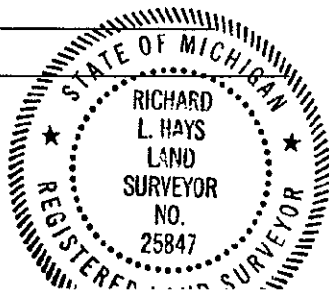

Corner D-13mc ratified by the Manistee County Peer Group according to the county plan adopted pursuant to P.A. 345 of 1990, as amended, (being the State Survey and Remonument Act, MCL 54.261 et seq.). Date of Peer Review: MAY 04 1999

Anthony M. Slawinski