

MAY 16 1997

COMMISSION

LAND CORNER RECORDATION CERTIFICATE

Filing Requirement of Act 74, Mich. P.A. 1970

For corners in

MANISTEE
(County)

Located In:

Corner Code #

REGISTER'S OFFICE
MANISTEE COUNTY

96-367 at 10:30
AUG 23 1996

Perry A. Repere
REGISTER OF DEEDS

Register of Deeds Stamp & File Number

1. Public Land Survey T 21N R 13W M-8
T R
T R
T R
2. Property Controlling S T R
In Section S T R
3. Miscellaneous S T R
Property in Sec. S T R

4. Lot No. Recorded Plat
5. Private Claims

I, Kenneth L. Ross, in a field survey on July 17, 1996, do hereby certify that under requirements of P.A. 74, Michigan P.A. of 1970, the corner points mentioned in lines 1 and 2 above were in conformance with regulations and rules therefore as required in the current manual of survey instructions of the United States Department of the Interior, Bureau of Land Management or by a decree of a Court of Law and/or that the corner points mentioned in lines 3, 4 and 5 above were in conformance with the rules of the Michigan Board of Land Surveyors or by a Decree of a Court of Law, established, re-established, monumented, re-monumented, recovered, found as expressed below:

NOTE: Not more than 4 corners, all in the same town and range, may be recorded on this certificate.

A. Description of original monument and accessories and/or subsequent restoration:

M-8 1/4 Cor., 24-21-13
1839 John Brink
(1) 14" W. Pine N 20 W 9 lks
(2) 10" W. Pine S 62 W 12 lks

	A	B	C	D	E	F	G	H	I	J	K	L	M
1													
2	6	5	4	3	2	1							
3													
4	7	8	9	10	11	12							
5													
6	18	17	16	15	14	13							
7													
8	19	20	21	22	23	24							
9													
10	30	29	28	27	26	25							
11													
12	31	32	33	34	35	36							
13													


B. Description of corner evidence found and/or method applied in restoring or reestablishing corner:

M-8 1/4 Cor., 24-21-13
July, 1909, Fargo Eng. Co. Rd no US evidence, monument not given (Book A, Page 8)
(3) 12" Y. Pine S 53 E 40 lks
(4) 12" W. Oak S 53 W 98.25 lks
Aug., 1963, Robert Griffin Rd. 9" x 18" Square Stone set on end with lime around and stumps of 3 & 4, replaced with 2" x 5" Wrought Iron Pipe filled with concrete and set 1.5' above ground and filed Act 74 (June 1973) Liber 73, Page 71
(5) 10" dock spike in 16" W. Pine (scribed BT) N 08 E 54.45'
(6) "X" cut in top center boulder N 89 E 60.45'
(7) "X" cut in top center boulder S 23 E 23.40'
(8) 10" dock spike in 7" W. Oak (scribed BT) S 48 W 73.10'
(9) 5" x 7' Cedar Post South 1.4'
Aug., 1992, Norman Caldwell for USDA Forest Service Rd. 2" Wrought Iron Pipe per Liber 73, Page 71
same witness as # 5, 6, 7, 8, & 9
July, 1996, K. Ross Rd. 2" x 5' Wrought Iron Pipe filled with concrete as set by Griffin, 1.5' above ground in center 40' diameter clear cut area

C. Description of monument for corner and accessories established to perpetuate locating the position of the corner:

M-8 1/4 Cor., 24-21-13
Fd. Witness #5 (now 18"), 6, 7, 8 (now 11"), & 9.
Witness #1, 2, 3, & 4 gone.
Left 2" x 5' Wrought Iron Pipe filled with concrete in place, and is accepted as the available evidence of the original corner.

ratified by the Manistee County Peer Group
according to the county plan adopted pursuant to P.A. 345 of 1990,
as amended, (being the State Survey and Remonument Act, MCL 54.261
at seg. 1)
Date of Peer Review AUG 6 1996
Anthony M. Shumski

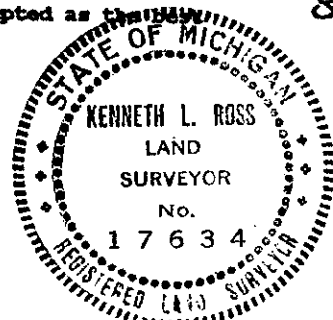

Signed by *K. Ross* 8-596 Date

Surveyor's Michigan License No *K. Ross*