

LAND CORNER RECORDATION CERTIFICATE
Filing Requirement of Act 74, Mich. P.A. 1970

For corners in

MANISTEE

(County)

Located in:

Corner Code =##

REGISTER'S OFFICE
MANISTEE COUNTY

#93-570 HT 4:10 p.m.

OCT 5 1993

Penny A. Rogers
REGISTER OF DEEDS

Register of Deeds Stamp & File Number

1. Public Land Survey

T 21N R 14W

E-13 ✓

T R

T R

33 T -21N R -14W

-33-15

2. Property Controlling
in Section

S T R

3. Miscellaneous
Property in Sec.

S T R

S T R

4. Lot No. , Recorded Plat

5. Private Claims

I, Norman C. Caldwell, in a field survey on November 19 91

do hereby certify that under requirements of P.A. 74, Michigan P.A. of 1970, the corner points mentioned in lines 1 and 2 above were in conformance with regulations and rules therefore as required in the current manual of survey instructions of the United States Department of the Interior, Bureau of Land Management or by a decree of a Court of Law and/or that the corner points mentioned in lines 3, 4 and 5 above were in conformance with the rules of the Michigan Board of Land Surveyors or by a Decree of a Court of Law; established, re-established, monumented, re-monumented, recovered, found as expressed below:

NOTE: Not more than 4 corners, all in the same town and range, may be recorded on this certificate.

A. Description of original monument and accessories and/or subsequent restoration:

E-13 Standard cor., 32 & 33, T21N-R14W

33-15 W 1/16, South Line, Sec. 33

Post placed by John Brink in 1842, township survey of 2nd correction line.
N43°E 25 lks. (16.5') 10" Beech
N15°W 7 lks. (4.6') 14" Yellow Pine

This position not established by original government survey.

B. Description of corner evidence found and/or method applied in restoring or reestablishing corner:

E-13 Standard cor., 32 & 33, T21N-R14W

33-15 W 1/16, South Line, Sec. 33

G.H. Johnson in 1913 witnessed the following:
S40°W 17 lks. (11.2') 12" White Pine
S29°E 40 lks. (26.2') 13" Maple
S79°W 55' 20" Pine stump
S35°E 53' 18" Pine stump
East 141.90' Closing cor. 5 & 6
(Baird in 1909 found old corner & witnesses)
N69°W 52 lks. (34.3') 6" Poplar
N83°E 36 lks. (23.8') 18" White Pine stump

No Subsequent Record

C. Description of monument for corner and accessories established to perpetuate locating the position of the corner:

E-13 Standard cor., 32 & 33, T21N-R14W

33-15 W 1/16, South Line, Sec. 33, T21N-R14W

Placed 6" x 6" x 36" sq. conc. monument w/brass cap #16923 on 2nd correction line and in accord with topographic calls of original government survey and is accepted as a careful and faithful reestablishment of the position of the original corner.
N31°W 38.46' 5" B. Oak
East 1.0' Carsonite Witness Post
SE 149.14' Iron pipe
S12°W 44.03' 5" Maple
N89°W 53.51' 5" Maple

Placed 5/8" x 2" rerod w/alum. cap #16923 in 1991. This position not established by original government survey. This monument is accepted as a careful and faithful determination of the position of the corner.
S22°E 36.01' 6" Maple
S11°W 35.21' 8" White Birch
N51°W 26.85' 7" Maple
South 10.0' CL 2 track road
North 1.0' Carsonite Witness Post


Signed by

Date

Surveyor's Michigan License No.

12018

	A	B	C	D	E	F	G	H	I	J	K	L	M
2	6	5	4	3	2	1							
3													
4	7	8	9	10	11	12							
5													
6	18	17	16	15	14	13							
7													
8	19	20	21	22	23	24							
9													
10	30	29	28	27	26	25							
11													
12	31	32	33	34	35	36							
13													

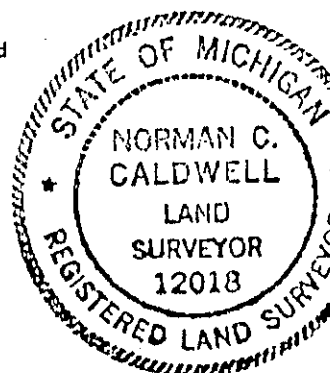

13
Corner Peer Group pursuant to P.A. 123 of
County Peer Group pursuant to P.A. 345 of 1990, as
1915, as amended by P.A. 345 of 1990, as
Date of Peer Review: MAY 3 1993