

1993

LAND CORNER RECORDATION CERTIFICATE
Filing Requirement of Act 74, Mich. P.A. 1970

COMMISSION

For corners in
Manistee

(County)

Located In:

Corner Code ##

REGISTER'S OFFICE
MANISTEE COUNTY

- | | | |
|------------------------------------|---------------------------|------------|
| 1. Public Land Survey | T <u>22N</u> R <u>14W</u> | <u>B-9</u> |
| | T _____ R _____ | _____ |
| | T _____ R _____ | _____ |
| | T _____ R _____ | _____ |
| 2. Property Controlling in Section | S _____ T _____ R _____ | _____ |
| | S _____ T _____ R _____ | _____ |
| 3. Miscellaneous | S _____ T _____ R _____ | _____ |
| Property in Sec. | S _____ T _____ R _____ | _____ |

FEB 2 1993

NO. 93-43 At 9:20 AM.
REGISTER OF DEEDS

Register of Deeds Stamp & File Number

4. Lot No. _____, Recorded Plat _____
5. Private Claims _____

A	B	C	D	E	F	G	H	I	J	K	L	M
2	6	5	4	3	2	1						
3												
4	7	8	9	10	11	12						
5												
6	18	17	16	15	14	13						
7												
8	19	20	21	22	23	24						
9												
10	30	29	28	27	26	25						
11												
12	31	32	33	34	35	36						
13												

I, **Robert F. Mitchell**, in a field survey on May, 19 92, do hereby certify that under requirements of P.A. 74, Michigan P.A. of 1970, the corner points mentioned in lines 1 and 2 above were in conformance with regulations and rules therefore as required in the current manual of survey instructions of the United States Department of the Interior, Bureau of Land Management or by a decree of a Court of Law and/or that the corner points mentioned in lines 3, 4 and 5 above were in conformance with the rules of the Michigan Board of Land Surveyors or by a Decree of a Court of Law; established, re-established, monumented, re-monumented, recovered, found as expressed below:

NOTE: Not more than 4 corners, all in the same town and range, may be recorded on this certificate.

A. Description of original monument and accessories and/or subsequent restoration:

B-9; South $\frac{1}{4}$ Corner Section 19; Originally established during U.S. Survey conducted by O. Risdon in 1847 and monumented with a wood post witnessed by a Black Ash 9" N26°W 32 Lks and a Beech 8" S10°E 29 Lks. In 1902 this corner was rewitnessed by Manistee County Surveyor H. Knight as recorded in Book "B" pp 120-121, of the Manistee County Surveyor Records. In 1909 this corner was remonumented with an iron pipe and lime and rewitnessed by Fargo Engineering.

B. Description of corner evidence found and/or method applied in restoring or reestablishing corner:


B-9; South $\frac{1}{4}$ Corner Section 19; Found an $1\frac{1}{2}$ " by 30" iron pipe and lime memorial 7' north of the centerline of east-west trail road. This monument is in agreement with both Knight witnesses of 1902 and one Fargo Engineering witness of 1909; namely, a Black Oak 6" N20 $\frac{1}{2}$ °E 45 Lks which is no longer living and exists as a sprouted stump. Replaced found iron pipe with a 2" by 30" stainless steel pipe with 3" brass cap set flush with the ground.

C. Description of monument for corner and accessories established to perpetuate locating the position of the corner:

B-9; South $\frac{1}{4}$ Corner Section 19
Set a 2" x 30" Stainless Steel Pipe with 3" Brass Cap flush with the ground

N08°E - 8" Red Oak - 59.15'
S23°E - 6" White Pine - 32.42'
S43°W - 6" White Pine - 43.59'
N53°W - 12" White Oak - 55.70'
West - carsonite post - 1.0'

Corner B-9 ratified by the Manistee County Peer Group pursuant to P.A. 123 of 1915, as amended by P.A. 345 of 1990, as amended. Date of Peer Review: May 4 1993

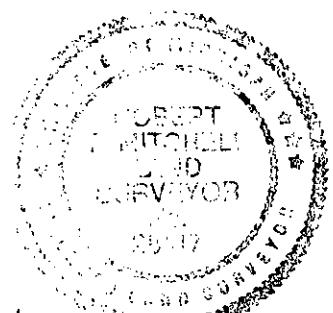

Signed by

[Signature]

Date

6-11-92

Surveyor's Michigan License No. 28417