

LAND CORNER RECORDATION CERTIFICATE
Filing Requirement of Act 74, Mich. P.A. 1970

1993

COMMISSION

For corners in

Manistee
(County)

Located In:

Corner Code #

1. Public Land Survey

T _____ R _____

T _____ R _____

T _____ R _____

T 22W R 15W

2. Property Controlling
in Section

S 19 T 22N R 14W

S _____ T _____ R _____

3. Miscellaneous
Property in Sec.

S _____ T _____ R _____

S _____ T _____ R _____

4. Lot No. _____, Recorded Plat _____

5. Private Claims _____

REGISTER'S OFFICE
MANISTEE COUNTY

FEB 2 1993

NO. 93-39 AT 9:00 AM
REGISTER OF DEEDS

Register of Deeds Stamp & File Number

I, Robert F. Mitchell, in a field survey on August, 19 92,
do hereby certify that under requirements of P.A. 74, Michigan P.A. of 1970, the corner points mentioned
in lines 1 and 2 above were in conformance with regulations and rules therefore as required in the
current manual of survey instructions of the United States Department of the Interior, Bureau of Land
Management or by a decree of a Court of Law and/or that the corner points mentioned in lines 3, 4 and 5
above were in conformance with the rules of the Michigan Board of Land Surveyors or by a Decree of a
Court of Law; established, re-established, monumented, re-monumented, recovered, found as
expressed below:

NOTE: Not more than 4 corners, all in the same town and range, may be recorded
on this certificate.

A. Description of original monument and accessories and/or subsequent restoration:

Indian Reserve Corner on West line of Section 19; This corner was not
established during the original U.S. Survey conducted by J. Brink in 1839. In 1900 J.
Millard, Manistee County Surveyor established this corner.


B. Description of corner evidence found and/or method applied in restoring or reestablishing corner:

Indian Reserve Corner on West line of Section 19; Found no evidence of
Millard's witnesses of 1900 as recorded in Book "B" pp. 54-55 of the Manistee County
Surveyor Records. Set a 2" x 30" galvanized pipe with 3" brass cap at proportionate
distance between controlling government corners.

C. Description of monument for corner and accessories established to perpetuate locating the position of the corner:

Indian Reserve Corner on West Line of Section 19;
Set a 2" x 30" galv. pipe w/ 3" brass cap
flush with the ground.

South - $W\frac{1}{2}$ Corner Sec. 19 - 137.06'
S65°E - 6" Black Ash - 44.82'
S39°E - 7" Black Ash - 47.22'
S05°W - 13" Black Ash - 61.59'
S51°W - 6" Black Ash - 34.29'
South - carsonite post - 1.0'

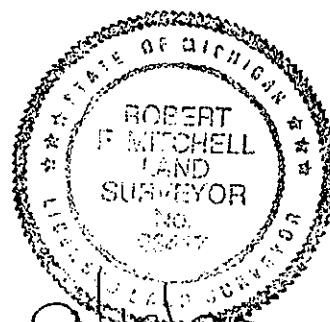

Signed by

Date

Surveyor's Michigan License No.

28417

	A	B	C	D	E	F	G	H	I	J	K	L
2	6	5	4	3	2							
3												
4	7	8	9	10	11	12						
5												
6	18	17	16	15	14	13						
7												
8	19	20	21	22	23	24						
9												
10	30	29	28	27	26	25						
11												
12	31	32	33	34	35	36						
13												

ratified by the Manistee
County Peer Group pursuant to P.A. 123 of
1915, as amended by P.A. 345 of 1990, as
amended. Date of Peer Review: JAN 4 1993