

SURVEY & REMONUMENTATION

FEB 08 2000

LAND CORNER RECORDATION CERTIFICATE

Filing Requirement of Act 74, Mich. P.A. 1970

SECTION
For corners in
MASON
(County)

Located In:

Corner Code #

1. Public Land Survey T 17N R 17W E-9
T R
T R
T R
2. Property Controlling S T R
in Section S T R
3. Miscellaneous S T R
Property in Sec. S T R

4. Lot No. , Recorded Plat
5. Private Claims

I, Kenneth L. Ross, in a field survey on May 15, 1999, do hereby certify that under requirements of P.A. 74, Michigan P.A. of 1970, the corner points mentioned in lines 1 and 2 above were in conformance with regulations and rules therefore as required in the current manual of survey instructions of the United States Department of the Interior, Bureau of Land Management or by a decree of a Court of Law and/or that the corner points mentioned in lines 3, 4 and 5 above were in conformance with the rules of the Michigan Board of Land Surveyors or by a Decree of a Court of Law; established, re-established, monumented, re-monumented, recovered, found as expressed below:

NOTE: Not more than 4 corners, all in the same town and range, may be recorded on this certificate.

A. Description of original monument and accessories and/or subsequent restoration:

E-9, Corner Common to Sections 20, 21, 28 and 29, T.17N., R.17W.,
GLO by John Hodgson, April, 1898, Book 2, page 76,
4th quarter, 1838 R.O. Towns, "Stones"
Set post common to Secs. 20, 21, 28 & 29 No Witnesses Given
(1) Beech, 12", S18°W, 22 links(14.52') Distance East to F-9, 2641.32'
(2) Beech, 10", N17°E, 19 links(12.54') Distance South to E-10, 2631.10'

September, 1888, Book 1, page 202
A. Mitchell, No comment on corner
Distance West to D-9, 2662.44'
Distance East to F-9, 2653.20'

April, 1892, Book 1, page 256
W.E. Metcalf, No comment on Corner
Distance North to E-8, 2635.38'
Distance East to F-9, 2653.204

February, 1967, Consumers Power Co.
K.B. Stephens No comment on corner.
Distance South to E-10, 2638.28'
Distance West to D-9, 2669.60'

May, 1968, Consumers Power Co.
K.B. Stephens, Fd. 3/8" iron rod
(3) P.P. SW, 51.57'
(4) Road Sign, S35°E, 45.96'
(5) 24" Maple, N30°E, 51.17'
Distance North to E-8, 2633.82'
Distance East to F-9, 2649.82'

April, 1975, Act 132
K.L. Ross, "Ex. 3/8" iron"
(3) P.P. S45°W, 51.57'
Witnesses (4) and (5) given

April, 1979, Act 132
K.L. Ross, "Ex. 3/8" iron"
No Witnesses
Distance East to F-9, 2649.34'
Distance South to E-11, 5276.68'

July, 1980, Act 132
Dennis Dunlap, "5/8" rod"
(3), 52.20' (5) given
(6) Stop Sign, NW, 55.20'
Distance West to D-9, 2669.68'

September, 1982, Act 132
September, 1988, Act 132
K.L. Ross, No Comment on Cor.
Distance West to D-9, 2669.70'

B. Description of corner evidence found and/or method applied in restoring or reestablishing corner:

E-9, Corner Common to Sections 20, 21, 28 and 29, T.17N., R.17W.,
Found 3/8" X 18" re-rod with small stones and wood stake, on the center-line of Anthony Road and the center-line of Morton Road projected. Witnesses (1), (2), (4), and (5) have been destroyed. Witnesses (3) and (5) are standing and in good condition. I found no other evidence to dispute the location of this corner.


C. Description of monument for corner and accessories established to perpetuate locating the position of the corner:

E-9, Corner Common to Sections 20, 21, 28 and 29, T.17N., R.17W.,
I replaced the 3/8" X 18" re-rod, as described above in the exact location, with a Harrison cast iron monument stamped MASON COUNTY MONUMENT, placed 3" below the road surface and placed a Monument Box. This corner is accepted as a careful and faithful re-establishment of the position of the original corner.

- (3) P.P. Set 60d spike, SE side, S45°W, 52.00'
(5) 30" Maple, Set 60d Spike, SE side, N35°E, 50.78'
(7) Center of Stop Sign Post, S26°E, 44.14'
(8) Center of Stop Sign Post, N35°W, 40.35'

Signed by
Surveyor's Michigan License No. 17634

Date 7-21-99

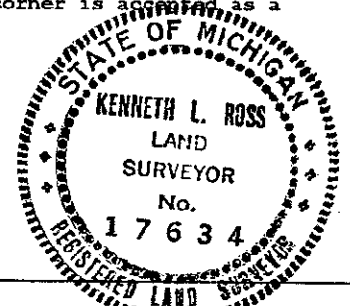

Peer Group Reviewed
and Approved
Date: 7-21-99
Kenneth L. Ross

FORM APPROVED BY MICHIGAN STATE BOARD OF LAND SURVEYORS, JAN. 26, 1971
REVISED MAY 14, 1975
REVISED JAN., 1982
ADAPTED FOR WORD PROCESSING MARCH, 1993

LIBER

4 PAGE 262