

DEC 18 1995

COMMISSION

LAND CORNER RECORDATION CERTIFICATE

Filing Requirement of Act 74, Mich. P.A. 1970

For corners in
MASON

(County)

Located In:

Corner Code #

1. Public Land Survey

T18 N R 16 W

I-10

T R

T R

T R

2. Property Controlling
In Section

S T R

S T R

3. Miscellaneous


S T R

Property in Sec.

S T R

4. Lot No. , Recorded Plat

5. Private Claims

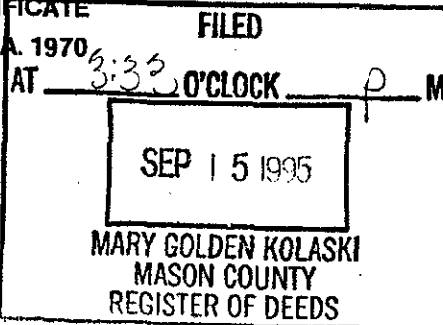

Register of Deeds Stamp & File Number

	A	B	C	D	E	F	G	H	I	J	K	L	M
2	6		5		4		3		2		1		
3													
4	7		8		9		10		11		12		
5													
6	18		17		16		15		14		13		
7													
8	19		20		21		22		23		24		
9													
10	30		29		28		27		26		25		
11													
12	31		32		33		34		35		36		
13													

I, Sammy S. Barnett, in a field survey on , 19 95, do hereby certify that under requirements of P.A. 74, Michigan P.A. of 1970, the corner points mentioned in lines 1 and 2 above were in conformance with regulations and rules therefore as required in the current manual of survey instructions of the United States Department of the Interior, Bureau of Land Management or by a decree of a Court of Law and/or that the corner points mentioned in lines 3, 4 and 5 above were in conformance with the rules of the Michigan Board of Land Surveyors or by a Decree of a Court of Law; established, re-established, monumented, re-monumented, recovered, found as expressed below:

NOTE: Not more than 4 corners, all in the same town and range, may be recorded on this certificate.

A. Description of original monument and accessories and/or subsequent restoration:

I-10 1/4 Corner for Sections 26 and 27, T18N, R16W.

1838, Sylvester Sibley D.S., G.L.O.

Set Wood Post

#1 Beech 10" S 50° E 121ks. (7.92')

#2 Beech 8" N 63° W 181ks. (11.88)

1884, James Jones, Dep. Co. Surv.

Found Gov't. Stake & Witnesses

1886, W.E. Metcalf, Dep. Co. Surv.

Found Gov't. Stake & Witnesses OK

1903, R.O. Towns, Co. Surv.

Found or Set Stone

No new witnesses

1991, Ken Ross, M.C.S.

Found 3/4" Iron Pipe

#3 R. Pine 8" S82°W 22.72'

#4 R. Pine 8" S14°W 102.72'

#5 R. Pine 8" S45°W 21.95'

#6 R. Pine 8" S60°E 84.58'

(OVER)

B. Description of corner evidence found and/or method applied in restoring or reestablishing corner:

I-10 1/4 Corner for Sections 26 and 27, T18N, R16W.

On August 8, 1995 I found a 3/4" Iron Pipe at the North end of Stephens Road, I found no other Iron or Markers or any other evidence to dispute this location for the Corner.

Condition of Recorded Witnesses is; #1 Gone #2 Gone #3 Found in good cond. #4 Found in good cond. #5 Found in good cond. #6 Gone #7 Same as #5 #8 Gone #9 Found in fair cond.

C. Description of monument for corner and accessories established to perpetuate locating the position of the corner:

I-10 1/4 Corner for Section 26 and 27, T18N, R16W.

I replaced 3/4" Iron Pipe with a 5/8" Re-Rod, 24" long, with an aluminum cap, stamped MASON COUNTY MONUMENT


I set Re-Rod 0.5 foot below ground surface, and is accepted as a careful and faithful reestablishment of the position of the original corner.

OBJ #3 Red Pine 10" S 82° W 22.72' (60d spike in NW side of tree)

OBJ #4 Red Pine 10" S 14° W 102.72' (60d spike in NW side of tree)

OBJ #5 Red Pine 10" S 35° W 21.95' (60d spike in NW side of tree)

Red Pine 10" S 62° E 89.29' (60d spike in SW side of tree)

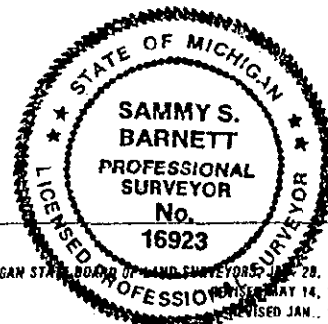

Signed by Sammy S. Barnett

Date 9-8-95

Surveyor's Michigan License No. 16923

Peer Group Reviewed

and Approved

Date: 9-12-95

Kenneth L. Ross
Mason County Surveyor

FORM APPROVED BY MICHIGAN STATE BOARD OF LAND SURVEYORS, JAN. 28, 1971
REVISOR MAY 14, 1975
REVISED JAN., 1983

LIBER

3 PAGE 285

I-10 1/4 Corner for Sections 26 and 27, T18N, R16W.

1967, Ken Stephens, M.C.S.

Set 3/4" Iron Pipe @ single proportional method

#7 Red Pine 4" S 35° W 22.00'

#8 Jack Pine 4" S 45° E 31.40'

#9 Fence corner post North 8.1'