

SURVEY &
REMONUMENTATION

APR 28 1995

COMMISSION

LAND CORNER RECORDATION CERTIFICATE
Filing Requirement of Act 74, Mich. P.A. 1970


For corners in

MASON
(County)

Located In:

Corner Code ##

1. Public Land Survey T 19N R 18W L-13
T R
T R
T R
T R
2. Property Controlling S T R
in Section S T R
3. Miscellaneous S T R
Property in Sec. S T R
4. Lot No. , Recorded Plat
5. Private Claims

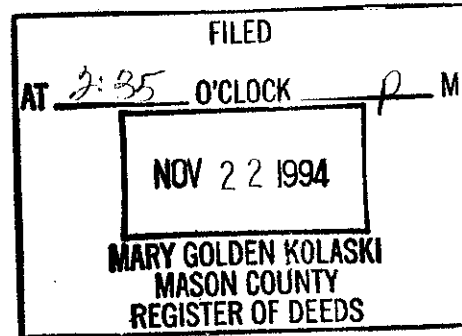

Register of Deeds Stamp & File Number

I, Theodore H. Weinert, in a field survey on OCTOBER, 19 94, do hereby certify that under requirements of P.A. 74, Michigan P.A. of 1970, the corner points mentioned in lines 1 and 2 above were in conformance with regulations and rules therefore as required in the current manual of survey instructions of the United States Department of the Interior, Bureau of Land Management or by a decree of a Court of Law and/or that the corner points mentioned in lines 3, 4 and 5 above were in conformance with the rules of the Michigan Board of Land Surveyors or by a Decree of a Court of Law; established, re-established, monumented, re-monumented, recovered, found as expressed below:

NOTE: Not more than 4 corners, all in the same town and range, may be recorded on this certificate.

A. Description of original monument and accessories and/or subsequent restoration:


L-13 1/4 Corner, Secs. 36
G.L.O. Notes Set Post
July, 1838, Sylvester Sibley
1 chain West of stream
6" Maple N 66 W 13 lks
9" Maple S 37 E 21 lks

B. Description of corner evidence found and/or method applied in restoring or reestablishing corner:

L-13 1/4 Corner, Secs. 36
Found 3/8" X 18" iron rebar pointed on end
4.58' West of N 1/4 corner Section 1, T18N, R18W.
Corner was 66.00' West of stream as called for in
G.L.O. Notes
This corner location is accepted as a careful and
faithful perpetuation of the original corner.

C. Description of monument for corner and accessories established to perpetuate locating the position of the corner:

L-13 1/4 Corner, Secs. 36
Set 5/8" X 36" rebar with standard 2 1/2" cap
stamped "Mason County Remonumentation".
Dbl. 8" & 12" Maple N 64 W 52.34'
8" Maple N 70 E 51.70'
12" Maple S 45 E 33.70'
18" Maple S 35 W 20.55'
On CL Decker Road
N 1/4 Corner Section 1, T18N, R18W, East 4.58'

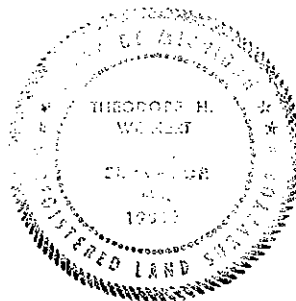

Signed by

Theodore H. Weinert

Date

11/6/94

Surveyor's Michigan License No. 19846

Peer Group Reviewed
and Approved

Date:

11-7-94

Kenneth L. Ross
Mason County Surveyor

FORM APPROVED BY MICHIGAN STATE BOARD OF LAND SURVEYORS, JAN. 28, 1971
REVISED MAY 14, 1975
REVISED JAN., 1983

LIBER

3 PAGE 236