

MAR 08 1994

COMMISSION

LAND CORNER RECORDATION CERTIFICATE

Filing Requirement of Act 74, Mich. P.A. 1970

FILED

For corners in

MASON

(County)

Located in:

Corner Code 11

AT 10:45 O'CLOCK

9

1. Public Land Survey

T 19N R 15W

T 19N R 15W

T R

T R

2. Property Controlling
in Section

S T R

S T R

3. Miscellaneous
Property in Sec.

S T R

S T R



1884 1933
MARY GOLDEN KOLASKI
MASON COUNTY
REGISTER OF DEEDS

Register of Deeds Stamp & File Number

4. Lot No. Recorded Plat

5. Private Claims

	A	B	C	D	E	F	G	H	I	J	K	L	M
2	6	5	4	3	2	1							
3													
4	7	6	5	4	3	2	1						
5													
6	18	17	16	15	14	13	12	11	10	9	8	7	6
7													
8	19	20	21	22	23	24	25	26	27	28	29	30	31
9													
10	30	29	28	27	26	25	24	23	22	21	20	19	18
11													
12	31	32	33	34	35	36	37	38	39	40	41	42	43
13													

John Schulke

in a field survey on Sept. 21 and June 30th, 1993
do hereby certify that under requirements of P.A. 74, Michigan P.A. of 1970, the corner points mentioned
in lines 1 and 2 above were in conformance with regulations and rules therefore as required in the
current manual of survey instructions of the United States Department of the Interior, Bureau of Land
Management or by a decree of a Court of Law and/or that the corner points mentioned in lines 3, 4 and 5
above were in conformance with the rules of the Michigan Board of Land Surveyors or by a Decree of a
Court of Law; established, re-established, monumented, re-monumented, recovered, found as
expressed below:

NOTE: Not more than 4 corners, all in the same town and range, may be recorded
on this certificate.

A Description of original monument and accessories and/or subsequent restoration:

G-2 Original survey established in 1838 by Sibley.
Set a wooden post with the following references:
Bearing trees: Beech 10" S46°E 5 lks.
Beech 8" N72°W 43 lks.

In 1890, Manistee/Grand Rapids Railroad found
corner, no new references. The following
railroad information:

Station 730+10.5 bears West 466.2 ft. of the corner.
Station 736+23.5 bears South 386.4 ft. of the corner.
Station 742+84 railroad intersect logging railroad.

H-3 Original survey established in 1838 by Sibley.

Set a wooden post with the following references:
Bearing trees: Cedar 14" N06°E 19 lks.
Cedar 10" S08°W 11 lks.

In 1890, Manistee/Grand Rapids Railroad recovered
corner. Station 770+77 bears North 106.5 ft. of the
corner

Station 772+97 bears East 158.0 ft. of the corner


No date, Lunde iron pipe 8 ft. South of grade.

CONTINUE ON BACK

B. Description of corner evidence found and/or method applied in restoring or reestablishing corner:

G-2 Found intersection of Manistee Railroad grade and
logging grade at station 742+84. Restored corner
by measuring Northwesterly along center line of
grade to Stations 736+23.5 and 730+10.5. From
Station 736+23.5 measured North 386.4 ft. and
from Station 730+10.5 measured East 466.2 ft. to
restore corner position. Found pine stump with
chop marks (chop marks facing the direction of corner)
bears S24°E a distance of 12.0 ft. Found other
pine stump 18" Dia. with chop marks (chop marks
facing the direction of corner) bears N69°E a distance
of 33.2 feet.

H-3 Found monument described by Griffin. The position
not accepted because of Railroad records and large
deflection (over 5°) to North at corner. Found
badly decayed cedar stump (accepted as BT to SW as GLO).

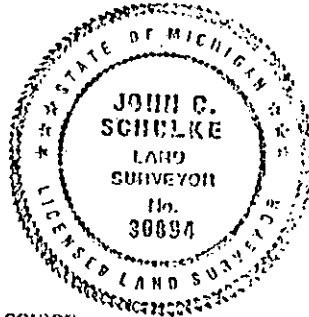

C Description of monument for corner and accessories established to perpetuate locating the position of the corner:

G-2 Set 2 1/2" dia. x 30" iron pipe with a brass cap
stamped to identify the corner. Set fiberglass
1.2 feet East of corner. The following corner
references:

W Pine 14" S12°W 26.31 ft.
W Oak 6" N79°W 39.54 ft.
W Oak 5" S88°W 51.33 ft.
W Oak 4" N64°E 18.31 ft.

H-3 Reset concrete monument by Griffin and stamped 1993-
JS-RLS-30894 on the cap. Reset wood post with location
tag Northwest 2.5 ft. from the corner. The following
corner references:
R Maple 14" N40°W 22.52 ft.
R Maple 16" S21°W 21.39 ft.
R Maple 12" S16°E 47.37 ft.
R Maple 16" N48°E 10.52 ft.

Signed by John C. Schulke
Surveyor's Michigan License No. RLS-30894

Date Nov 9, 1993

Peer Group Reviewed

and Approved

Date: 11-9-93

Kenneth L. Fox

Mason County Surveyor

FORM APPROVED BY MICHIGAN STATE BOARD OF LAND SURVEYORS, JAN 28 1971
REVISED MAY 14, 1975
REVISED JAN 1987

LIDER

3 PAGE 147

continued column "A"

- H-3 In 1979, K. Ross found 3/4" iron pipe 8 ft. from the Center line of grade.
In 1980, R. Griffin found 3/4" iron pipe and replaced it with 1 1/2" X 60" concrete filled iron pipe with brass cap (see corner certificate Liber 2, Page 86 in the Mason Co. Register of Deed's Office).