

LAND CORNER RECORDATION CERTIFICATE  
Filing Requirement of Act 74, Mich. P.A. 1970

For corners in

MASON Located In: Corner Code: I-11  
(County)


1. Public Land Survey T 19N R 15W I-11  
T      R       
T      R       
T      R      Seg. 2

2. Property Controlling S      T      R       
In Section S      T      R     

3. Miscellaneous S      T      R       
Property in Sec. S      T      R     

4. Lot No.     , Recorded Plat     

5. Private Claims     

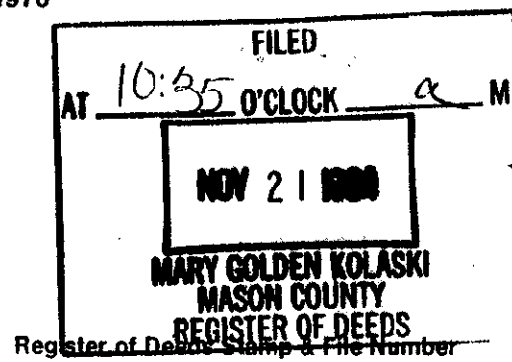

I, John Schulke, in a field survey on Nov. 5th, 19 94,  
do hereby certify that under requirements of P.A. 74, Michigan P.A. of 1970, the corner points mentioned  
in lines 1 and 2 above were in conformance with regulations and rules therefore as required in the  
current manual of survey instructions of the United States Department of the Interior, Bureau of Land  
Management or by a decree of a Court of Law and/or that the corner points mentioned in lines 3, 4 and 5  
above were in conformance with the rules of the Michigan Board of Land Surveyors or by a Decree of a  
Court of Law; established, re-established, monumented, re-monumented, recovered, found as  
expressed below:

NOTE: Not more than 4 corners, all in the same town and range, may be recorded  
on this certificate.

A. Description of original monument and accessories and/or subsequent restoration:

Original survey established in 1838 by Sibley.  
Set a wooden post with the following references:  
1. Beech 12" S15°W 26 lks.  
2. Maple 12" N32°E 22 lks.

In 1971, Ross shows an 1" iron pipe at the corner.  
6. Tel. pole S15°W 84.60 ft.  
7. Power pole S25°E 94.20 ft.

In 1896, J.W. Griswold (see Book 1, Page 309)  
found corner set by Eastman, no references.

In 1984, D. Dunlap indicated he found iron (see corner  
certificate Liber 2, page 224).

3. North 1/4 corner of Section 34 West 2633.4 ft.  
4. East 1/4 corner of Section 34 South 2566.7 ft.

In 1938, Survey by Lunde found 1 1/4" iron pipe  
and also a stone, said post being 32 ft. East and  
33.4 ft. North of a corner steel fence post.

5. East 1/4 corner of Section 34 established


B. Description of corner evidence found and/or method applied in restoring or reestablishing corner:

Recovered 1 1/4" iron pipe, stone on North side and on center line of Taylor and Sugar Grove Roads. Also  
found 1" iron pipe N34°21'E a distance of 3.62 ft.  
References #1, 2, 5, 6 and 7 not recovered  
North 1/4 corner of Section 34 N87°10'26"W (Grid bearing) 2633.83 ft.  
East 1/4 corner of Section 34 S0°53'00"W 2565.22 ft.  
Southeast corner of Section 34 S0°53'13"W 5131.20 ft. (Grid-Bearing & Distances)

SURVEY &  
REMONUMENTATION

MAR 16 1998

SECTION

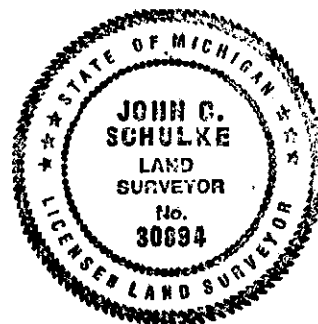

C. Description of monument for corner and accessories established to perpetuate locating the position of the corner:

Set 5/8" X2' rerod inside the 1 1/4" iron pipe with an aluminum cap monument stamped to identify the corner.  
The monument 10 inches below the surface of the road. The following corner references:

Power pole N14°W 96.31 ft.  
Power pole N20°E 88.12 ft.  
Apple 6" S60°E 40.99 ft.  
Road sign S69°W 42.3 ft.  
6"X6" treated wood post N48°E 50.35 ft.  
6"X6" treated wood post N87°E 36.94 ft.

(NOTE: Corner is accepted as the best evidence of the perpetuated location of the original corner).

Signed by John C. Schulke Date Nov 7, 1994

Surveyor's Michigan License No. PLS-30894

FORM APPROVED BY MICHIGAN STATE BOARD OF LAND SURVEYORS, JAN. 28, 1971  
and Approved  
Date: Feb 25, 1993  
Kenneth L. Ross  
Mason County Surveyor