

SURVEY &
REMONUMENTATION

APR 28 1995

COMMISSION

LAND CORNER RECORDATION CERTIFICATE

Filing Requirement of Act 74, Mich. P.A. 1970

For corners in

MASON
(County)

Located In:

Corner Code #

1. Public Land Survey

T 19N R 16W

M-5

T R

T R

T R

T R

2. Property Controlling
in Section

S T R

S T R

3. Miscellaneous
Property in Sec.

S T R

S T R

4. Lot No. , Recorded Plat

5. Private Claims

I, Theodore H. Weinert, in a field survey on JULY, 19 94,
do hereby certify that under requirements of P.A. 74, Michigan P.A. of 1970, the corner points mentioned
in lines 1 and 2 above were in conformance with regulations and rules therefore as required in the
current manual of survey instructions of the United States Department of the Interior, Bureau of Land
Management or by a decree of a Court of Law and/or that the corner points mentioned in lines 3, 4 and 5
above were in conformance with the rules of the Michigan Board of Land Surveyors or by a Decree of a
Court of Law; established, re-established, monumented, re-monumented, recovered, found as
expressed below:

**NOTE: Not more than 4 corners, all in the same town and range, may be recorded
on this certificate.**

A. Description of original monument and accessories and/or subsequent restoration:

M-5 Section Corner, Secs. 12 & 13, 19-16; 7 & 18, 19-15

G.L.O. Notes Set Post

July 7, 1838, Mullet & Brownfield

10" Beech N 60 W 54 lks

10" Hemlock S 35 W 27 lks

August 27-29, 1888, J. A. Mitchell staked corner
identified by old witnesses (Book 1, Page 199);

distance from this corner south to east 1/4 corner
2638.68 feet

September, 1901, R. O. Towns set stone while
completing a survey in Section 7, T.19N., R.15W.
(Book 2, Page 39 & Book 3, Page 54); distance from
this corner south to east 1/4 corner 2638.68 feet
August 3, 1988, Ken Ross, PLS, Rd PK Nail over
iron bar; distance from this corner south to east
1/4 corner 2644.76 feet

B. Description of corner evidence found and/or method applied in restoring or reestablishing corner:

M-5 Section Corner, Secs. 12 & 13, 19-16; 7 & 18, 19-15

Found PK Nail over iron bar

Fit distances as described by Ken Ross, PLS.

This corner location is accepted as a careful and
faithful perpetuation of the original corner.

C. Description of monument for corner and accessories established to perpetuate locating the position of the corner:

M-5 Section Corner, Secs. 12 & 13, 19-16; 7 & 18, 19-15

Set 5/8" X 36" rebar with standard 2 1/2" cap
stamped "Mason County Remonumentation", in
monument box.

Spike in Power Pole N 38 E 34.44'

Spike in Power Pole S 22 E 48.27'

Spike in Power Pole S 46 W 46.48'

Spike in Guy Pole N 46 W 53.18'

CL South Schoenherr Road West 2.5'

CL Fountain Road South 1.5'

CL North Schoenherr Road West 10.0'

Signed by

Date

Surveyor's Michigan License No. 19846

Peer Group Reviewed
and Approved

Date: 11-5-94


Kenneth L. Ross
Mason County Surveyor

FORM APPROVED BY MICHIGAN STATE BOARD OF LAND SURVEYORS, JAN. 28, 1971
REVISED MAY 14, 1975
REVISED JAN., 1983

LIBER

3 PAGE

218

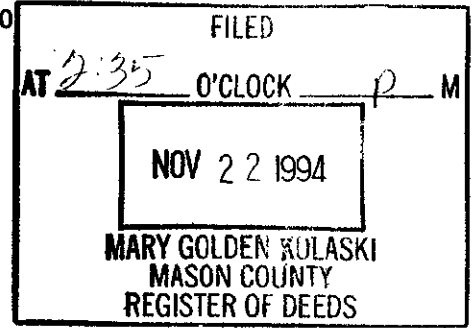

Register of Deeds Stamp & File Number

	A	B	C	D	E	F	G	H	I	J	K	L	M
2	6		5		4		3		2		1		
3													
4	7		8		9		10		11		12		
5													
6	18		17		16		15		14		13		
7													
8	19		20		21		22		23		24		
9													
10	30		29		28		27		26		25		
11													
12	31		32		33		34		35		36		
13													

