

SURVEY & REMONUMENTATION

MAY 07 1997

COMMISSION

LAND CORNER RECORDATION CERTIFICATE Filing Requirement of Act 74, Mich. P.A. 1970

For corners in

MASON
(County)

Located in:

Corner Code #

1. Public Land Survey

T20N R17W

M-01 WITNESS COR
W. SHINGLE LAKE

2. Property Controlling
in Section

S T R

#2

3. Miscellaneous
Property in Sec.

S T R

4. Lot No. , Recorded Plat

5. Private Claims

I, Sammy S. Barnett, in a field survey on July 26, 1996 do hereby state that under requirements of P.A. 74, Michigan P.A. of 1970, the corner points mentioned in lines 1 and 2 above were in conformance with regulations and rules therefore as required in the current manual of survey instructions of the United States Department of the Interior, Bureau of Land Management or by a decree of a Court of Law and/or that the corner points mentioned in lines 3, 4 and 5 above were in conformance with the rules of the Michigan Board of Land Surveyors or by a Decree of a Court of Law; established, re-established, monumented, recovered, found as expressed below:

NOTE: Not more than 2 corners, all in the same town and range, may be recorded on this certificate.

A. Description of original monument and accessories and/or subsequent restoration.

M-01 Witness to the NE corner for Section 1, T20N, R17W, on West side of Shingle Mill Lake.

1837, John Brink, G.L.O.

Set Wood Post

#1 B. Oak 14" S31°W 131ks.(8.58')

#2 B. Oak 11" N72½°W 281ks.(18.48')

1983, Robert A. Griffin, #13584

Set 1/2" re-rod w/ cap for witness to the NE Corner in Lake

#3 Red Maple 10" N56°W 23.54'

#4 Red maple 10" S15°W 50.14'

1993, Ken Ross, #17634

Found 1/2" re-rod by Griffin

#5 Red Maple 10" N56°W 23.54'

#6 Red maple 10" S15°W 50.14'

B. Description of corner evidence found and/or method applied in restoring or reestablishing corner:

M-01 Witness to the NE corner for Section 1, T20N, R17W, on West side of Shingle Mill Lake.

On July 26, I found 1/2" Re-rod set by Griffin at the waters edge, I found no evidence to dispute this location for the witness corner.

Condition of recorded witnesses are;

#1 Gone

#5 Same as 3

#2 Gone

#6 Same as 4

#3 Found in good condition

#4 Found in good condition

C. Description of monument for corner and accessories established to perpetuate locating the position of the corner:

M-01 Witness to the NE corner for Section 1, T20N, R17W, on the West side of Shingle Mill Lake.

I replaced 1/2" x 24" re-rod, in the exact location, with a Standard Mason County Monument, at the waters edge, and is accepted as a careful and faithful witness to the position of the original corner.

(ext. BT #3) Red Maple 10" N 56° W 23.54' (dock spike SE side of tree)

(ext. BT #4) Red Maple 10" S 15° W 50.14' (dock spike in SE side of tree)

White Oak 20" S 33° W 54.75' (60d spike in NW side of tree)

White Oak 12" S 83° W 52.40' (60d spike in NW side of tree)

Signed by Sammy S. Barnett
Surveyor's Michigan License No. 16923

Date 9-28-96

Peer Group Reviewed
and Approved

Date: 9-30-96
Ken Ross
Mason County Surveyor


FORM APPROVED BY MICHIGAN STATE BOARD OF PROFESSIONAL SURVEYORS, JAN. 20,

REVISED MAY 14
REVISED JAN.
REVISED OCT.

11RFR

4 PAGE

19

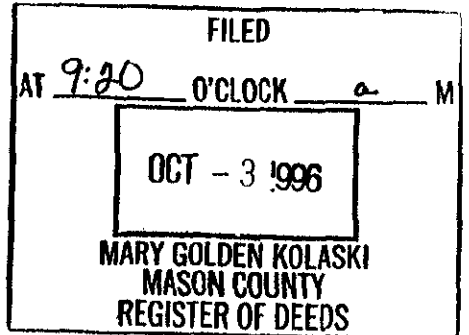

Register of Deeds Stamp & File Number

	A	B	C	D	E	F	G	H	I	J	K
1											
2	6		5		4		3		2		
3											
4	7		8		9		10		11		1
5											
6	18		17		16		15		14		1
7											
8	19		20		21		22		23		2
9											
10	30		29		28		27		26		2
11											
12	31		32		33		34		35		3
13											

