

FEB 26 1998

MECOSTA COUNTY REMONUMENTATION PROGRAM

CORNER APPROVED BY PEER GROUP ON December 12, 1997

SECTION

LAND CORNER RECORDATION CERTIFICATE

Filing Requirement of Act 74, Mich. P.A. 1970

STATE OF MICHIGAN
COUNTY OF MECOSTA
RECEIVED FOR RECORD

For corners in

MECOSTA

(County)

Located In:

Corner Code #

'97 DEC 29 A10:06

1. Public Land Survey T 15N R 09W A-03
T R
T R
T R
2. Property Controlling S T R
in Section S T R
3. Miscellaneous S T R
Property in Sec. S T R

James Brown
REGISTER OF DEEDS

Register of Deeds Stamp & File Number

4 Lot No. Recorded Plat
5 Private Claims

I, Thomas H. Sage, in a field survey on November 26, 1997, do hereby certify that under requirements of P.A. 74, Michigan P.A. of 1970, the corner points mentioned in lines 1 and 2 above were in conformance with regulations and rules therefore as required in the current manual of survey instructions of the United States Department of the Interior, Bureau of Land Management or by a decree of a Court of Law and/or that the corner points mentioned in lines 3, 4 and 5 above were in conformance with the rules of the Michigan Board of Land Surveyors or by a Decree of a Court of Law, established, re-established, monumented, re-monumented, recovered, found as expressed below:

	A	B	C	D	E	F	G	H	I	J	K	L	M
1													
2		6		5		4		3		2		1	
3													
4		7		8		9		10		11		12	
5													
6		18		17		16		15		14		13	
7													
8		19		20		21		22		23		24	
9													
10		30		29		28		27		26		25	
11													
12		31		32		33		34		35		36	
13													

NOTE: Only one corner may be recorded on this certificate.

A. Description of original monument and accessories and/or subsequent restoration:

G.L.O. Vol. 2, Pg. 123, 277 & 288

Set Post for Cor. Sec.s 1 & 12:

Hemlock 10 S10W 17

Beech 10 N68W 34

- After running West on Random between

Sec. 6&7 T15N - R9W; New Wit.:

Pine 12 N71E 11

Do. 24 S60E 13

(1895) Co. Surveyor

Co. Surveyor Book; Pg. 281

Iron Stake

(Oct. 10 1983) Henry Mulder, PS#25862

L.C.R.C.: L. 02, Pg. 83

Iron Rod in 4" Clay Tile:

P.K. nail, S. Side P. Pole, S80°W, 48.90' #1

Nail, S. Side Fnc. Cor. Post, East, 24.46' #2

Nail, W. Side 20" Ash, N15°E, 72.75' #3

Nail, E. Side Fnc. Post, S40°W, #4

B. Description of corner evidence found and/or method applied in restoring or reestablishing corner:

Found 3" (ID) stacked Clay Tiles, but no Iron. Clay Tile Checked with accessories.

- On C/L Gravel Road N. / S.; On Fence Line E. / W.

- Accessories: #1) Found; #2) Found; #3) Tree present nail missing; #4) Gone

- Accepted position of clay tile as best evidence of the perpetuation of the corner.

C. Description of monument for corner and accessories established to perpetuate locating the position of the corner:

- (17 Dec 97) Replaced Clay Tile with Mecosta County Remonumentation Monument.

- Top of Monument set 0.5' below gravel surface.

- Monument surrounded with pieces of found Clay Tile.

- On C/L Gravel Road N. / S.; On Fence Line E. / W.

- Found P.K. Nail, S. Side P. Pole, S80°W, 48.91' #1

- Set Nail & Remon. Tag, W. Face 25" Ash, N15°E, 72.74' #3

- Set Nail & Remon. Tag, S. Face 6" Ash, N70°W, 32.60'

- Set Nail & Remon. Tag, NW. Face 6" Elm, N50°E, 59.18'

- Monument is accepted as a careful and faithful perpetuation of the position of the original corner.

APPROVED BY MECOSTA CO. PEER GROUP
IN ACCORDANCE WITH P.A. 345 of 1990

CHAIRMAN

DATE

James H. Knapp
DEC. 12, 1997


Signed by Thomas H. Sage

Surveyor's Michigan License No.

33139

Date December 17, 1997

JSS

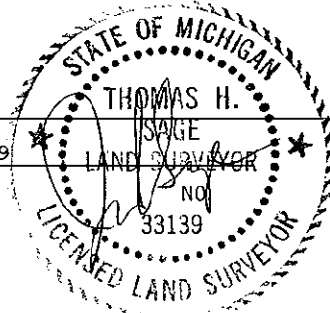

FORM APPROVED BY MICHIGAN STATE BOARD OF LAND SURVEYORS, JAN. 28, 1971
REVISED MAY 14, 1975
REVISED JAN., 1983
ADAPTED FOR WORD PROCESSING MARCH, 1993