

LAND CORNER RECORDATION CERTIFICATE
Filing Requirement of Act 74, Mich. P.A. 1970

For corners in

MIDLAND
(County)

Located In:

Corner Code #

1. Public Land Survey T13N R2W E-8
T R
T R
T R
2. Property Controlling S T R
in Section S T R
3. Miscellaneous S T R
Property in Sec. S T R
4. Lot No. , Recorded Plat
5. Private Claims

215

STATE OF MICHIGAN
MIDLAND COUNTY
FILED

19 JUL 95 10:52 A.M.

BEVERLY J THAYER
REGISTER OF DEEDS
Register of Deeds Stamp & File Number

I, PAUL B. LAPHAM, in a field survey on MAY, 1995, do hereby certify that under requirements of P.A. 74, Michigan P.A. of 1970, the corner points mentioned in lines 1 and 2 above were in conformance with regulations and rules therefore as required in the current manual of survey instructions of the United States Department of the Interior, Bureau of Land Management or by a decree of a Court of Law and/or that the corner points mentioned in lines 3, 4 and 5 above were in conformance with the rules of the Michigan Board of Land Surveyors or by a Decree of a Court of Law; established, re-established, monumented, re-monumented, recovered, found as expressed below:

NOTE: Not more than 4 corners, all in the same town and range, may be recorded on this certificate.

A. Description of original monument and accessories and/or subsequent restoration:

E-8: 1/4 Corner common to Sections 20 & 21

1852 AUSTIN BURT, SET POST, ELM 22" N35°W 19 LKS., ELM 6" S62°E 21 LKS.

1899 C.S.R., COR. IS SET ON LINE 40.06 CH. FROM S.W. COR. & 40.08 CH. FROM N.W. COR.

WITNESS NOTE: Witnesses from above surveys and LCRC's are available in dossier file; which was presented to peer review committee and is on file at the Register of Deeds Office.

B. Description of corner evidence found and/or method applied in restoring or reestablishing corner:

E-8: 1/4 Corner common to Sections 20 & 21


Set Corner at S.P.M. (2644.64' (Rec. 2643.96') from S.W. and 2645.96' (Rec. 2645.28' from N.W.)) Between S.W. & N.W. Sec. Cor. Corner falls in line with old fence West & Field line to East. Set new Mon. Box.

Corner, E-8 was approved for remonumentation at a Peer Review Committee Meeting on 6-6, 1995.
C. Description of monument for corner and accessories established to perpetuate locating the position of the corner:

E-8: 1/4 Corner common to Sections 20 & 21

Set 5/8" x 18" re-rod with brass cap stamped "Midland Co. Remon. Cor. PS 9433" in Monument Box per C.S.R. Survey. Accepted as best available evidence of accepted position of the corner.

S48°W 141.02' N.E. COR. HOUSE
S61°W 111.62' - N&T IN POWER POLE
S13°E 165.38' - N&T IN TELE. POLE
EAST 198.25' - N&T IN POWER POLE
EAST 5' - Q SEAL COAT PVM'T.

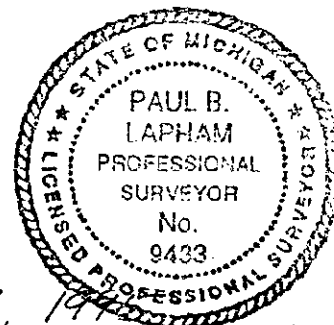

Signed by

Paul B. Lapham

Date

June 7, 1995

Surveyor's Michigan License No.

9433