

APPROVED LAND CORNER
P.A. 345 OF 1990
MIDLAND COUNTY

4/25/95 J.P.J.

REMON. COR. C-10, CITY OF MIDLAND
LAND CORNER RECORDATION CERTIFICATE
Filing Requirement of Act 74, Mich. P.A. 1970

204

For corners in
Midland

(County)

Located In:

Corner Code #

1. Public Land Survey

T 14N R 2E

C-10

T R

T R

T R

2. Property Controlling
in Section

S T R

S T R

3. Miscellaneous
Property in Sec.

S T R

S T R

4. Lot No. , Recorded Plat

5. Private Claims

STATE OF MICHIGAN
MIDLAND COUNTY
FILED

11 MAY 95 3:16 P.M.

BEVERLY J THAYER
REGISTER OF DEEDS

Register of Deeds Stamp & File Number

I, RODNEY CLAYPOOL, in a field survey on FEBRUARY 2, 1994, do hereby certify that under requirements of P.A. 74, Michigan P.A. of 1970, the corner points mentioned on lines 1 and 2 above were in conformance with regulations and rules therefore as required in the current manual of survey instructions of the United States Department of the Interior, Bureau of Land Management or by a decree of a Court of Law and/or that the corner points mentioned in lines 3, 4 and 5 above were in conformance with the rules of the Michigan Board of Land Surveyors or by a Decree of a Court of Law; re-established, monumented, re-monumented, recovered, found as expressed below:

NOTE: Not more than 4 corners, all in the same town and range, may be recorded on this certificate.

A. Description of original monument and accessories and/or subsequent restoration:

C-10 Corner common to Section 29 and 30


Survey by J. Jones 1983
Found 3/4" pipe

Government Survey 1839, Page 166
Survey by Dow 1955 (E2-87283)
Found Corner

Survey by M. Hunter 1958, 1963
Found Corner

Survey by J. Schafer 1973, 1974, 1976
Found 1/2" pipe in monument box

	A	B	C	D	E	F	G	H	I	J	K	L	M
2	6	5	4	3	2	1							
3													
4	7	8	9	10	11	12							
5													
6	18	17	16	15	14	13							
7													
8	19	20	21	22	23	24							
9													
10	30	29	28	27	26	25							
11													
12	31	32	33	34	35	36							
13													

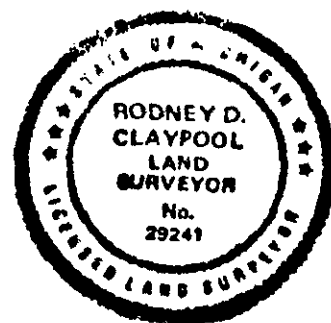

WITNESS NOTE: Witnesses from above surveys and LCRC's are available in dossier file; which was presented to peer review committee and is on file at the Register of Deeds Office.

B. Description of corner evidence found and/or method applied in restoring or reestablishing corner:

C-10 Corner common to Section 29 and 30

Found nail in iron in mon box (replaced with 3/4" pipe and brass cap), per survey by Dow, M. Hunter, D. Whittier, J. Schafer, and J. Jones.

Corner C-10 was approved for remonumentation at a Peer Review Committee Meeting on April 25, 1995.

C. Description of monument for corner and accessories established to perpetuate locating the position of the corner:

C-10 Corner common to Section 29 and 30

Found nail in iron in mon box (replaced iron with 3/4" pipe and brass cap stamped Midland Co. Remon Cor. PS 29241) per surveys by Dow, M. Hunter, D. Whittier, J. Schafer and J. Jones and is accepted as the best available evidence of the accepted position of the corner.

S 50 Deg, E 47.72', nail and plastic disc in power pole

N 30 Deg, E 126.10', nail and plastic disc in telephone pole

S 45 Deg, W 49.26', nail and plastic disc in power pole

N 50 Deg, W 56.77', nail and plastic disc in power pole

Signed by Rodney D. Claypool

Date 05-11-95

Surveyor's Michigan License No. 29241

Form approved by Michigan State Board of Land Surveyors, Jan. 28, 1971

Revised May 14, 1971

Revised Jan., 1983