

MIDLAND COUNTY REMONUMENTATION
LAND CORNER RECORDATION CERTIFICATE
Filing Requirement of Act 74, Mich. PA 1970

Midland
(County)

Located In

Corner Code #


1. Public Land Survey

| | | | | |
|---|------------|---|-----------|------------|
| T | <u>15N</u> | R | <u>1W</u> | <u>A13</u> |
| T | <u>15N</u> | R | <u>2W</u> | <u>M13</u> |
| T | <u>14N</u> | R | <u>1W</u> | <u>A1</u> |
| T | <u>14N</u> | R | <u>2W</u> | <u>M1</u> |

Register of Deeds Stamp & File Number

I, Craig W. McVean, in a field survey on July 7, 2011 do hereby state that under requirements of PA 74, Michigan PA of 1970, the corner points mentioned in lines 1 and 2 above were in conformance with regulations and rules therefore as required in the current manual of survey instructions of the United States Department of the Interior, Bureau of Land Management or by a decree of a Court of Law and/or that the corner points mentioned in lines 3, 4 and 5 above were in conformance with the rules of the Michigan Board of Land Surveyors or by a Decree of a Court of Law; established, re-established, monumented, recovered, found as expressed below:

NOTE: Not more than 2 corners, all in the same town and range, may be recorded on this certificate.

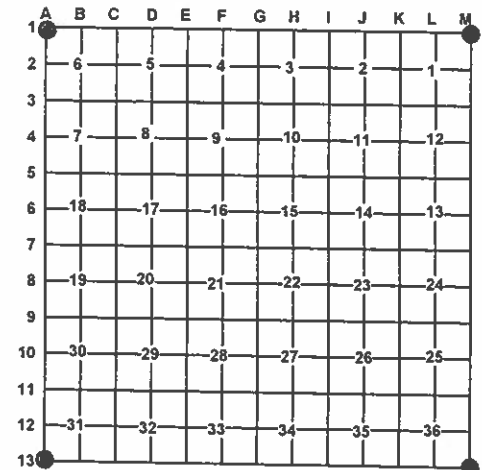

A. Description of original monument and accessories and/or subsequent restoration:

A13-M13-A1 & M1 -

- 1830 - GLO - R. Clark, Jr. - Int. W. Bdy 99 N. of post.
 - 1) Hemlock 28" S16°E 28 L.
 - 2) Hemlock 40" N68°W 12 L.
- 1907 - CSR - P. 241 & FB. T14N, R1W - F. J. Gibbs - Pine Post at proportionate measurement "Oak 44"-17.00 [W. Oak 44" and 17.00 - GLO] N. of Cor. 1 found lying down. Also Pine Stump 21.20 [Pine 16" - 21.20 - GLO] South of corner 1 which compares with line tree in Gov't notes. Also ran line West on S. Bdy 36 Geneva from point. 80 N. of Cor. 1 and int. 96 N. of Cor. of 35 & 36."
- 3) Pine Stp. N35°W 41 NB
- 4) Pine Stp. S52°E 108 NB

- 1919 - CSR - P. 400 - F. J. Gibbs - Old corner post standing.
- 1923 - F. J. Gibbs - FB. T14N, R1W - p. 122-123 - Old post found standing.
- 5) Pine Stp. N44°E 57
- 2010 - Rec. Survey - L. 7, p. 424 - J. R. Rosenbrook - set ½" rerod with cap #47973:
 - 6) N30°E 26.22' to set duplex NW face 6" Oak
 - 7) N50°W 48.23' to set duplex W. face Tw. 8" Maple
 - 8) S70°E 61.58' to set duplex NNE Face 10" Oak;
 - 3) N30°W 32.7' stp. of rotten pine
 - 9) South 15.08' set duplex E. face 6" Oak

B. Description of corner evidence found and/or method applied in restoring or re-establishing corner:

A13-M13-A1 & M1 - Township Corner common to Sec. 31, T15N, R1W; Sec. 36, T15N, R2W; Sec. 6, T14N, R1W & Sec. 1, T14N, R2W - Fd. 2" ± stake shadow - White sand with organics into light brown sand - and piece of wood stake. Fits remains of witnesses #3 (N32°W 27.6' to Face 24"± PS): #4 (S50°E 71.1'± to face 20"± PS remains to ground) and #5 (N43°E 37.6' to face 30"± Pine Stp.). Witnesses #6 to 9- Rejected corner position. Measured N 21'± vs. 33' GLO to edge of swamp. West 23'± to edge of swamp. No evidence of witnesses #1 or 2. Stake remains and shadow accepted as a careful and faithful reestablishment of the position of the original corner.

- Reference Pt. - Found ½" CIR #47973 is S37°33'E 4.03' of the recovered Gibbs Township corner. ½" CIR not utilized as "A13-M13-A1 & M1" in this survey.

C. Description of monument for corner and accessories established to perpetuate locating the position of the corner:

A13-M13-A1 & M1 - Replaced stake remains and shadow with stamped 4" DNR Alum. Cap on 1" x 36" galv. iron pipe.

- Set Blue Carsonite Post 1' NW
- N32°W 28.63' to set ½" x 24" iron rebar in centerline 24" Pine Stp. (#3)
- N52°W 44.32' to set Nail and Tag (N & T) at fd. nail in SW side 6" Tw. R. Maple
- N36°E 24.55' to set N & T at Fd. Nail in NW side 7" Oak
- N88°E 15.58' to set N & T in N. side 4" Oak
- S9°E 18.64' to set N & T at fd. Nail in E. side 8" Oak
- S37°33'E 4.03' to Reference Pt. - ½" CIR #47973

Signed by:

Craig W. McVean

Date:

10/15/2012

Surveyor's Michigan License No.:

39088

