

APPROVED LAND CORNER
P.A. 345 OF 1990
MIDLAND COUNTY

SURVEY &
REMONUMENTATION

APR 28 1995

110

LAND CORNER RECORDATION CERTIFICATE
Filing Requirement of Act 74, Mich. P.A. 1970

For corners in

MIDLAND
(County)

Located In:

Corner Code ##

1. Public Land Survey T16N R2E B-7
T R
T R
T R
2. Property Controlling S T R
in Section S T R
3. Miscellaneous S T R
Property in Sec. S T R

STATE OF MICHIGAN
MIDLAND COUNTY
REMONUMENTATION & FILED

11 OCT 94 4:08 P.M.

BEVERLY J THAYER
REGISTER OF DEEDS

Register of Deeds Stamp & File Number

4. Lot No. , Recorded Plat
5. Private Claims

| | A | B | C | D | E | F | G | H | I | J | K | L | M |
|----|----|----|----|----|----|----|---|---|---|---|---|---|---|
| 2 | 6 | 5 | 4 | 3 | 2 | 1 | | | | | | | |
| 3 | | | | | | | | | | | | | |
| 4 | 7 | 8 | 9 | 10 | 11 | 12 | | | | | | | |
| 5 | | | | | | | | | | | | | |
| 6 | 18 | 17 | 16 | 15 | 14 | 13 | | | | | | | |
| 7 | | | | | | | | | | | | | |
| 8 | 19 | 20 | 21 | 22 | 23 | 24 | | | | | | | |
| 9 | | | | | | | | | | | | | |
| 10 | 30 | 29 | 28 | 27 | 26 | 25 | | | | | | | |
| 11 | | | | | | | | | | | | | |
| 12 | 31 | 32 | 33 | 34 | 35 | 36 | | | | | | | |
| 13 | | | | | | | | | | | | | |

I, PAUL B. LAPHAM, in a field survey on JUNE, 19 94, do hereby certify that under requirements of P.A. 74, Michigan P.A. of 1970, the corner points mentioned in lines 1 and 2 above were in conformance with regulations and rules therefore as required in the current manual of survey instructions of the United States Department of the Interior, Bureau of Land Management or by a decree of a Court of Law and/or that the corner points mentioned in lines 3, 4 and 5 above were in conformance with the rules of the Michigan Board of Land Surveyors or by a Decree of a Court of Law; established, re-established, monumented, re-monumented, recovered, found as expressed below:

NOTE: Not more than 4 corners, all in the same town and range, may be recorded on this certificate.

A. Description of original monument and accessories and/or subsequent restoration:

B-7: 1/4 Corner common to Sections 18 and 19
1831 - Harvey Parke, Hemlock 16" N 44°W, 14 lks, Hemlock 11" S 26°E, 16 lks
No C.S.R.
1/25/74 - Leonard Urbaniak (132) 1-531, L.C.R.C. #279
1. S 30°E, 55.5' - R.R. Tie Fence Post
2. S 40°W, 78.3' - Power Pole (M-78.32')
3. S 45°W, 56.9' - 18" Yellow Pine Tree (M-56.75')
Attached copy of notes of this survey from private records.

B. Description of corner evidence found and/or method applied in restoring or reestablishing corner:


B-7: 1/4 Corner common to Sections 18 and 19
Established position with reference to Urbaniak Survey dated 1/25/74 the position of which was verified by line & measurement from S.E. Corner & East 1/8 Corner on South Section line of Section 18. Road appeared to have been rebuilt and raised. Found Recorded Witnesses 2 & 3.

Accepted as best available evidence of the position of the original corner & placed Standard Monument.

1/4 Corner B-7 was approved for remonumentation at a Peer Review Committee Meeting on 9-27, 1994.

C. Description of monument for corner and accessories established to perpetuate locating the position of the corner:

B-7: 1/4 Corner common to Sections 18 and 19
Set 5/8" x 18" re-rod with brass cap stamped "Midland Co. Remon. Cor. PS 9433" in Mon. Box.
S 40°W, 78.32' - Nail & Tag, Power Pole (2)
S 45°W, 56.75' - Nail & Tag, 18" Yellow Pine (3)
S 48°E, 29.90' - Nail & Tag, 7" Maple
SOUTH, 62.62' - Nail & Tag, 18" Pine

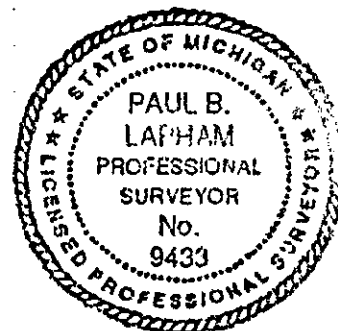

Signed by Paul B. Lapham

Date 9-30-94

Surveyor's Michigan License No. 9433